

MISSISSIPPI DEPARTMENT OF NATURAL RESOURCES

Bureau of Land and Water Resources

COUNTY WELL LOCATED
Pontotoc

WELL NUMBER
G

CODED

PERMIT NUMBER

NAME OF DRILLING FIRM
Leeper Drilling

DATE WELL COMPLETED
NOV 87

Pontotoc MS

P.O. Box 10631
Jackson, Mississippi 39209
WATER WELL DRILLERS LOG

NAME & MAILING ADDRESS OF LANDOWNER
Ray Martin

General Delivery

Pontotoc MS

WELL LOCATION: SEC' TOWNSHIP RANGE
8 10^N 3^E

DISTANCE DIRECTION NEAREST TOWN
1 1/2 Miles *S* of *Pontotoc*

OTHER LANDMARK
Hiway 15 Bypass

WELL PURPOSE: Home, Irrigation, Municipal, Industrial, Fish Pond, etc.
Home

PUMP DATA

PUMP TYPE (Circle One):
Submersible Turbine, Jet, Flowing Well, Other (Describe) _____

POWER TYPE (Circle One):
Electric Tractor, Diesel, Gasoline, Butane, Other (Describe) _____

Pump Capacity (GPM) No. of Stages Setting Depth
10 12 126' FT.

PUMP TEST

Well yielded _____ GPM with a drawdown of _____ ft. after _____ hours of pumping

WELL DATA

Well Depth <i>165'</i>	Casing Diameter (In.) <i>4"</i>	Casing Length (Ft.) <i>155'</i>
Type of Casing <i>PVC</i>	Hole Depth <i>165'</i>	Depth to Static Water Level <i>90'</i>

TYPE OF COMPLETION: (Circle One or More):
Gravel Packed, Underreamed, Telescoped, Natural Development, Open Hole, Other (Describe) _____

Top of Lap Pipe or Reduction in Casing

FEET IF TELESCOPED OR MORE THAN ONE SCREEN: USE BACK PAGE

LOG DATA

TYPE OF LOG RUN (Circle One): No Log Run, Electric, Gamma Ray, Density, Sonic, Neutron, Other (Describe) _____

Name of Organization Running Log

SCREEN DATA

Diameter - Inches <i>4"</i>	Length - Feet <i>10'</i>	Slot Size - Inches <i>#13</i>
Screen Type <i>Slotted PVC</i>	Depth to Bottom - Feet <i>165</i>	

GEOLOGIC DATA (Office Use Only)

Surface Elev.	Geologic Unit	Unit Thickness	Depth to Top
Subs. SWL	Date	Analysis	Aquifer Test

Driller's Remarks

DESCRIPTION OF FORMATIONS ENCOUNTERED	FROM	TO	FORMATIONS (continued)	FROM	TO
<i>Red Sand</i>	<i>0</i>	<i>58</i>			
<i>Blue Clay</i>	<i>58</i>	<i>95</i>			
<i>Rock & Sand</i>	<i>95</i>	<i>120</i>			
<i>SAND</i>	<i>120</i>	<i>165</i>			

IF MORE SPACE IS NEEDED, USE BACK


RECEIVED

DEC 21 1987

Department of Natural Resources
 Bureau of Land & Water Resources

If well telescopes please sketch and show depths.

GROUND LEVEL

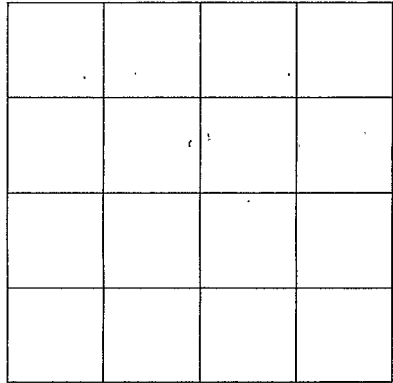

SECTION _____

Please indicate well location X.

ADDITIONAL INFORMATION

If more than one screen,
show location of each on sketch.