

H ~~2000~~
5-26-62

WATER WELL DRILLERS LOG

Date: 5-26, 1962, Driller: C. C. Webb County Lee


(Name)

(1) Owner of Land:	Description & Color of Materials Sand, Clay, Red Clay, Shell, etc.	Thick- ness Feet	Depth Feet
<p><u>J. H. Beckley</u> (Name) <u>Pontotoc miss</u> (Address)</p>	<p><u>Soil to 11 ft clay</u> <u>to 35 ft Blue</u> <u>marl to 56 ft</u> <u>water sand</u> <u>18 ft no water</u> <u>Blue marl to</u> <u>700 ft water</u> <u>Rock 4" water</u> <u>sand to 450 ft</u> <u>wtaw sand</u></p>		
(2) Location: <u>1/4</u> , <u>1/4</u> , Sec. <u> </u> T. <u> </u> R. <u> </u>			
<u>6</u> miles <u>East</u> , of <u>Pontotoc</u> (distance) (direction) (Nearest Town)			
(3) Topography: <input checked="" type="checkbox"/> (Hilly) <input type="checkbox"/> (Flat) <input type="checkbox"/> (Level)			
(4) Purpose of Well: <input checked="" type="checkbox"/> (Domestic Irrigation) <input type="checkbox"/> (Municipal, Industrial, Other)			

Information upon completion of well:

- (1) Diameter 4 inches.
- (2) Total Depth 850 feet.
- (3) Water Level 170 feet below top of ground.
- (4) Cased to 42 ft, Size 4"
- (5) Screen: Size 0, Length 0
- (6) Were any formations sealed against pollution?
 yes, 0 no.

If YES depth of formation _____
Why _____
Drillers Remarks: _____

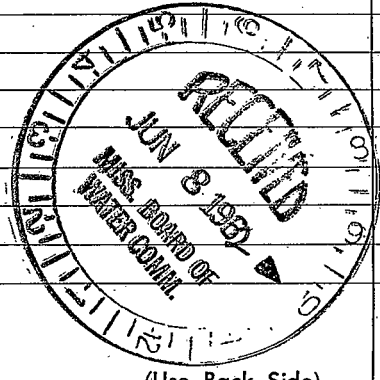

(Use Back Side)

Well No.

