

PONTOTOC

WATER WELL DRILLERS LOG

CODED

H 15  
Date: 3/9

1962, Driller: James L. ... County Pontotoc  
(Name)

- (1) Owner of Land: Robert H. Ray  
(Name)  
RT-3, Pontotoc, Miss  
(Address)  
NE  
(2) Location: 1/4, 1/4, Sec. 9, 10, 4  
7 miles EAST of Pontotoc,  
(distance) (direction) (Nearest Town)
- (3) Topography: Hilly  
(Hilly) (Flat) (Level)
- (4) Purpose of Well: Domestic  
(Domestic Irrigation  
Municipal, Industrial, Other)

Description & Color of Materials Sand, Clay, Red Clay, Shell, etc.	Thick- ness Feet	Depth Feet
<u>yellow clay</u>	<u>18 1/2'</u>	
<u>blue clay</u>	<u>42'</u>	
<u>sand</u>	<u>40 1/2'</u>	
<u>blue block</u>	<u>250'</u>	
<u>sand</u>	<u>162'</u>	


Information upon completion of well:

- (1) Diameter 4 inches.
- (2) Total Depth 790' feet.
- (3) Water Level 130 ft. feet below top of ground.
- (4) Cased to 22", Size 4"
- (5) Screen: Size \_\_\_\_\_, Length \_\_\_\_\_
- (6) Were any formations sealed against pollution?  
 yes, \_\_\_\_\_ no.

CODED

If YES depth of formation \_\_\_\_\_  
Why \_\_\_\_\_

Drillers Remarks: \_\_\_\_\_  
\_\_\_\_\_  
\_\_\_\_\_

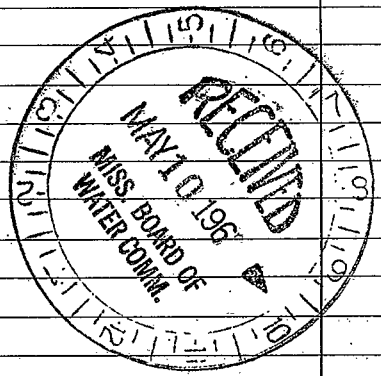

(Use Back Side)

Well No.

