

PONTOTOC
H 17
7-2-71

MISSISSIPPI
BOARD OF WATER COMMISSIONERS
416 North State Street
Jackson, Mississippi 39201

CODED

WATER WELL DRILLERS LOG

Herndon-Homan Well & Supply, Inc.

P. O. Box 42

Pontotoc

7-2 1971
date well completed

SHANNON, MISSISSIPPI 39063

county well located

LANDOWNER: *N. L. Jagers*
Route 3
Ingels, Miss.
(mailing address)

description of formations encountered	from	to
<i>Surface sand clay</i>	<i>0</i>	<i>35</i>
<i>Blue clay</i>	<i>35</i>	<i>480</i>
<i>SAND</i>	<i>480</i>	<i>620</i>
<i>Bottom</i>	<i>620</i>	

WELL LOCATION:
sec. *23* T. *10* N. R. *4* E
S
2 miles *SE* of *Plymouth*
(distance) (direction) (nearest town)

WELL PURPOSE: *Home*
(home, irrigation, municipal, industrial)

- WELL COMPLETION DATA:
- (1) diameter (inches) *5"*
 - (2) total depth (feet) *620'*
 - (3) static water level (feet) *128* below top of ground.
 - (4) casing *Steel*, *40'*
(material) (depth)
 - 5"*
(size) if telescope see back.
 - (5) screen *no*
(length) (depth to top)
 - (size) (material)
 - (6) pump *3/4* *5*
(HP) (yield gpm)
 - electric*
(type power)
 - (7) electric log *no*
(yes or no)
 - (organization running log)
 - (8) how well bottom plugged *open*

CODED


JUL 19 1971

MISS. BD. OF
WATER COMMISSIONERS

DRILLERS REMARKS:

If well telescopes please sketch and show depths.

GROUND LEVEL

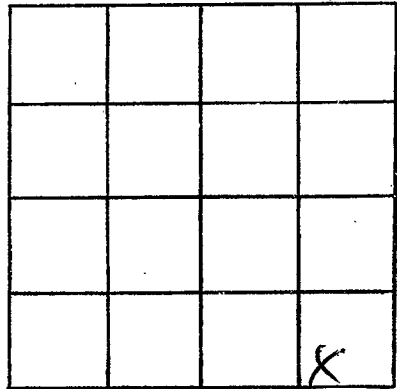

SECTION 23

Please indicate well location X.

ADDITIONAL INFORMATION

If more than one screen, show locations of each on sketch.