

CODED

Pontotoc
H-18
7-66

WATER WELL DRILLERS LOG

Date: July 5, 1966, Driller: Johnny Webb County: Pontotoc
(Name)

(1) Owner of Land: Banks Kirkpatrick
(Name)
Furn's Miss
(Address)

(2) Location: 1/4, 1/4, Sec. 11 T10^S R4E,
8 miles West, of Zupelo,
(distance) (direction) (Nearest Town)

(3) Topography: X
(Hilly) (Flat) (Level)

(4) Purpose of Well: Domestic
(Domestic Irrigation
Municipal, Industrial, Other)

Description & Color of Materials Sand, Clay, Red Clay, Shell, etc.	Thick- ness Feet	Depth Feet
<u>Top soil</u>	<u>0</u>	<u>5</u>
<u>Clay</u>	<u>5</u>	<u>12</u>
<u>Blue Marl</u>	<u>12</u>	<u>245</u>
<u>Blue marl mixed with sand</u>	<u>295</u>	<u>600</u>
<u>Waty Sand</u>	<u>600</u>	<u>720</u>

Information upon completion of well:

(1) Diameter 4 inches.

(2) Total Depth 720 feet.

(3) Water Level 160 feet below top of ground.

(4) Cased to 21', Size 4"

(5) Screen: Size _____, Length _____


(6) Were any formations sealed against pollution?
_____ yes, _____ no.

If YES depth of formation _____

Why _____

Drillers Remarks: Very sandy,
in Blue Marl around
300'

CODED

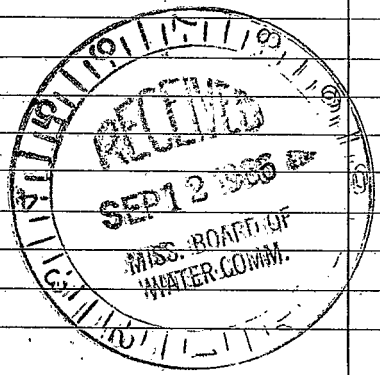

tain this copy for your office files.

(Use Back Side)

Well No.

