

CODED

Pantotoc

H-19

6-68

MISSISSIPPI
BOARD OF WATER COMMISSIONERS

416 North State Street
Jackson, Mississippi 39201

WATER WELL DRILLERS LOG

CODED

6-7-

19 68 Ewing Guss Co

Pantotoc

date well completed

firm name

county well located

LANDOWNER:

Charles Wright

description of formations encountered

from to

(mailing address)

WELL LOCATION:

sec 26 T-10 N R 4 E
3 miles SW of Jura
(distance) (direction) (nearest town)

Mud sand & clay	0	28
Blue	28	100
Sand & stone	100	240
Blue	240	280
Sand & stone	280	326
Light sand	326	450
Sand	450	635

WELL PURPOSE:

home (home, irrigation, municipal, industrial)

WELL COMPLETION DATA:

- (1) diameter (inches) 4"
- (2) total depth (feet) 635
- (3) static water level (feet) 905 below top of ground
- (4) casing 31 (material) (depth)
- (5) screen (length) (depth to top)
- (6) pump (size) (material) (yield gpm) (type power)
- (7) electric log (yes or no)
- (8) how well bottom plugged

CODED


17 1968

DRILLERS REMARKS:

MISS. BD. OF WATER COMMISSIONERS

If well telescopes please sketch and show depths.

GROUND LEVEL

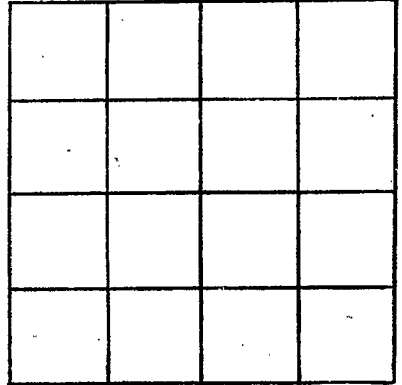

SECTION _____

Please indicate well location X.

ADDITIONAL INFORMATION

If more than one screen, show locations of each on sketch.