

H21  
10-65

WATER WELL DRILLERS LOG

Date: October, 1965, Driller: Johnny Webb County: Pontotoc  
(Name)

**CODED**

	Description & Color of Materials Sand, Clay, Red Clay, Shell, etc.	Thick- ness Feet	Depth Feet
(1) Owner of Land: <u>Elvis Jagers</u> (Name)	<u>dry to 25'</u>		
<u>Pontotoc, Mississippi</u> (Address)	<u>Blue mud 25 to 400'</u>		
(2) Location: <u>1/4</u> , <u>1/4</u> , Sec. <u>6 T10 R7</u> ,	<u>Sand &amp; Blue mud 400 - 690'</u>		
<u>6</u> miles <u>East</u> of <u>Pontotoc</u> , (distance) (direction) (Nearest Town)	<u>Water sand 690 - 810'</u>		
(3) Topography: <u>X</u> (Hilly) (Flat) (Level)			
(4) Purpose of Well: <u>Domestic</u> (Domestic Irrigation Municipal, Industrial, Other)			

Information upon completion of well:


- (1) Diameter 4 inches.
- (2) Total Depth 810 feet.
- (3) Water Level 140' feet below top of ground.
- (4) Cased to 42', Size 4"
- (5) Screen: Size \_\_\_\_\_, Length \_\_\_\_\_
- (6) Were any formations sealed against pollution?  
\_\_\_\_\_ yes, \_\_\_\_\_ no.

If YES depth of formation \_\_\_\_\_

Why \_\_\_\_\_

Drillers Remarks: \_\_\_\_\_

**CODED**

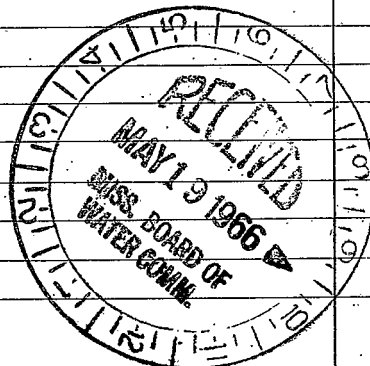

(Use Back Side)

Well No.

100

100

100

100