

PONTOTOC
 H 22
 10-15-72

MISSISSIPPI
 BOARD OF WATER COMMISSIONERS
 416 North State Street
 Jackson, Mississippi 39201

WATER WELL DRILLERS LOG

CODED

10-15-1972
 date well completed

Leepur Drilling Co - Pontotoc
 firm name county well located

LANDOWNER:
 Ray Leepur, Jr.
 Rt 3 - Pontotoc
 (mailing address)

description of formations encountered	from	to
Red Clay -	0	15
Red sand & Blue clay	15	30
Blue clay & Rock	30	200
Blue clay & Rock	200	450
Chalk	450	600
Sand	600	725

WELL LOCATION:
 sec. 21 T 10 N R 4 E
 8 miles SE of Pontotoc
 (distance) (direction) (nearest town)

WELL PURPOSE: Domestic
 (home, irrigation, municipal, industrial)

- WELL COMPLETION DATA:
- (1) diameter (inches) 6"
 - (2) total depth (feet) 725
 - (3) static water level (feet) 140 below top of ground.
 - (4) casing 42 (material) (depth)
 (size) if telescope see back.
 - (5) screen 105' slotted pipe (length) (depth to top)
2 1/2" (size) steel (material)
 - (6) pump 3 (HP) 20 (yield gpm)
Elect. (type power)
 - (7) electric log no (yes or no)
 - (organization running log)
 - (8) how well bottom plugged pref pipe


CODED

DRILLERS REMARKS:

DEC 29 1972

If well telescopes please sketch and show depths.

GROUND LEVEL

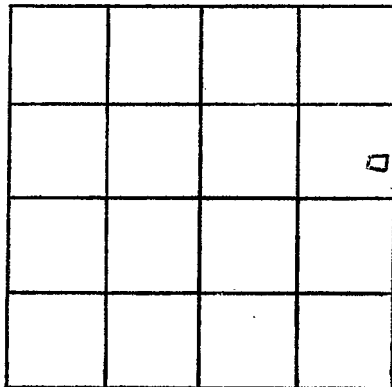

SECTION 21-

Please indicate well location X.

ADDITIONAL INFORMATION

If more than one screen,
show locations of each on sketch.