

H25

CODED

MISSISSIPPI
 BOARD OF WATER COMMISSIONERS
 416 North State Street
 Jackson, Mississippi 39201

Pontotoc
DDT
4-69

WATER WELL DRILLERS LOG

date well completed 19 4-69 firm name J.W. Webb & Son county well located Pontotoc

LANDOWNER: Pontotoc County

description of formations encountered	depth	
	from	to
Soil	0	20
blue sand clay	20	50
blue rock	50	800
water sand	800	980

Pontotoc Miss
(mailing address)

WELL LOCATION:
 sec 31 T 9S N R 4E
5 10SS
4 miles East of Pontotoc
 (distance) (direction) (nearest town)

WELL PURPOSE:
(home, irrigation, municipal, industrial)

WELL COMPLETION DATA:

- (1) diameter (inches) 6
- (2) total depth (feet) 980
- (3) static water level (feet) 195 below above top of ground.
- (4) casing steel, 500,
(material) (depth)
6 if telescope see back.
(size)
- (5) screen 50, 480
(length) (depth to top)
4", Stainless Steel
(size) (material)
- (6) pump 2.0 100
(HP) (yield gpm)
Elec
(type power)
- (7) electric log NO
(yes or no)
- (8) how well bottom plugged _____
(organization running log)

DRILLERS REMARKS:

APR 22 1969



MISS. BD. OF
WATER COMM.

MISS. BD. OF
WATER COMM.

⑩

If well telescopes please sketch and show depths.

GROUND LEVEL

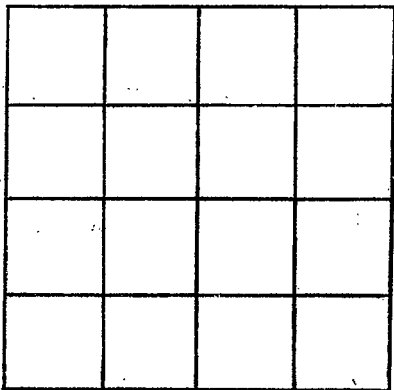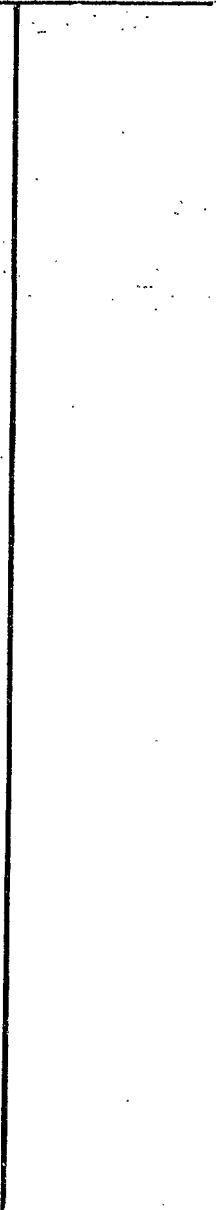

SECTION 31

Please indicate well location X.

ADDITIONAL INFORMATION

If more than one screen, show locations of each on sketch.
