
		ell Report		
County: PONTOTOC		Driller's Log	For Office Use Only:	
County: <u>PONTOTOC</u> Permit #: GW 16242		and Water Resources	Aquifer:	
Driller: PARKS + PARKS WELL		30x 10631 18 39289-0631	L. S. Elevation:	
Date drilling completed: 5-9-2004	(601)	961-5210		
	(601)35	4-6938 (fax)	E-log #:	
State Law requires that this report be prepared by the license holder responsible for the work and filed with the Department at the above address within 30 days of completion of drilling of the well or borehole.				
Information on Well Owner		Well or Borehole Location		
(Landowner if borehole is not for a water well) Owner Name $\frac{1}{2AST}$ $\frac{PONTOTOC}{ONTOTOC}$ $\frac{1028}{29}$ Mailing Address: $\frac{PO}{100}$ $\frac{1028}{100}$		Latitude: <u>34° 14</u> ' <u>33N</u> " Longitude: <u>88° 53</u> '09W,		
		Method of Lat/Long (circle on		
			GPS Survey-grade GPS	
PONTOL M	<u>S 38863</u> State Zip Code	, · · · · · · · · · · · · · · · · · · ·		
·	•	Distance Direction	Nearest Town of	
Telephone No. ()			/	
Well / Borehole Data				
Date drilling started: $\frac{3}{1/2004}$ Date drilling completed: $\frac{5-9-2006}{5-9-2006}$ Hole depth: $\frac{1/200}{1/200}$ Hole diameter: $\frac{17^{1/2}}{2}$				
Location of the source of any surface water used for drilling: <u>EAST</u> <u>fortotoc</u> <u>what tek</u> <u>ASSN</u> . Method of dosing and volume of Chlorine used in drilling and development: <u><u>SPPN</u></u>				
Logs run (circle all applicable): No log run Klectric Gamma Ray Density Sonic Neutron Other:				
Purpose of borehole (check one): Water Well 🖉 Geotechnical/Geological Investigation Ground Source Heat Pump				
Seismic Survey Other (<i>describe</i>) If drilling is not related to water well construction, skip the remainder of this block				
Purpose of Well (check one): Home Industrial Public Supply Irrigation Fish Culture Other:				
If a flowing well, method of flow regulation: Valve Other (describe)				
Static Water Level: <u>246,5</u> feet above or below (circle one) land surface Date measured: <u>5-/2-2006</u>				
Method of Measurement (circle one) steel tape electric tape air line other:				
Well depth: <u>910</u> Well grouted to a depth of <u>795</u> feet Type of grout (circle one): Neat Cement Bentonite Mix				
Casing length: <u>795</u> feet Casing diameter: <u>/2</u> inches Type of casing: <u>STEAL</u>				
Screen length: <u>/00</u> feet Screen diameter: <u>8</u> inches Type of screen: <u>Site interss</u> <u>Street</u>				
Screen slot size:				
Type of completion (circle all applicable): Gravel packed Underreamed Telescoped Open hole Natural Development				
Other (describe):				
Top of lap pipe or reduction in casing:	7.50 feet. If tel	escoped or more than one scree	n, describe on next page	
Form: OLWR-SWR-1A				
RECEIVED				

MAY 3 0 2006 BY: OLWR

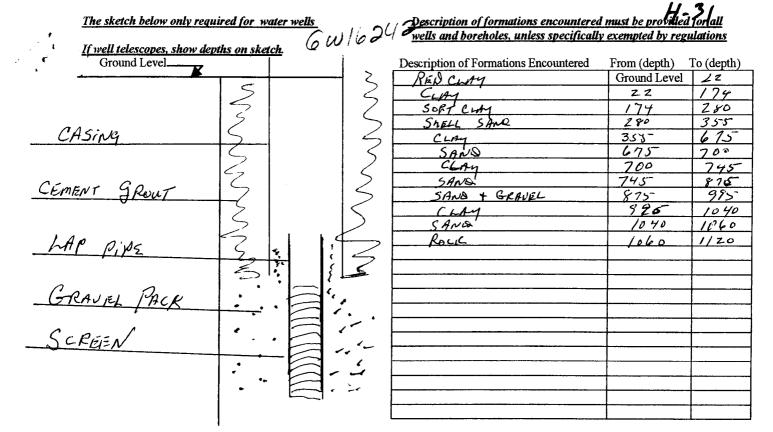

If more than one screen, show location of each on sketch

aid in locating the well; 3) any roads, power lines, or other items that may aid in 4) a north arrow.	
	+ WEW TANK
ner Ro	, t. m,
Hurry Le	1 N
Landowner Name:	Form: OLWR-SWR-1/

I certify that the well/borehole was drilled, constructed, and completed in accordance with all applicable requirements of the Mississippi Depagtment of Environmental Quality and the Mississippi Department of Health regulations, if applicable, and state

laws. 5/24/06 WURN TARKS 0-414 Tou on

Print Name of Responsible Licensee and License No.

Date

Signature of Licensee **RECEIVED**

MAY 3 8 2006 BY: OLWR

STATE WELL REPORT			
County: <u>PONTOTOL</u> Permit #: <u>G(W) 1 (0242</u> Driller: <u>PARKS+PARKES WELL SEC</u> /22 Date completed: <u>1.142007</u>	Part 2 's Completion Report nt of Environmental Quality and Water Resources Box 10631 MS 39289-0631)961-5210 54-6938 (fax) contractor or a licensed pump installer. A copy of Part 1 of the		
Telephone No. ()	Distance Direction Nearest TownMiles of		
Pump Type Circle one Air Lift Jet Submersible Bucket Piston Turbine Centrifugal Rotary Flowing Well Other (specify):	Power Type Circle one Diesel Engine Gasoline Engine Natural Gas Electric Motor Hand Tractor PTO Windmill Other (specify):		
Pump Test Data Date Well Tested: $1 - 1/-2667$ Static Water Level (A): $24/6.5^{-}$ Feet Below Land Surface Pumping Water Level (B): 347.25^{-} Feet Below Land Surface Drawdown [(B) - (A)]: 100.75^{-} Feet Below Land Surface Test Pumping Rate: 302 Gallons Per Minute Duration of Pump Test (minimum 4 hours): 4 hours	Method of Measuring Water Level Circle one Air Line Electric Measuring Line Steel Tape Other (specify):		
I HEREBY CERTIFY that the above statements are true to the best of my knowledge A y bus have a factor of the best of my knowledge Print Name of Pump Installer and License No. (if applicable) Form RECEIVE			

,

FEB 16 2007

BY: OLWR