

MISSISSIPPI DEPARTMENT OF NATURAL RESOURCES

Bureau of Land and Water Resources

Southport Mall

P.O. Box 10631

Jackson, Mississippi 39209

WATER WELL DRILLERS LOG

H 2000
PONTOTOC
4-85

APRIL 1985 Leeper Drilling Pontotoc
date well completed firm name county well located.

LANDOWNER: F.W. Merrett
BLACK ZION Community
PONTOTOC MS.
(mailing address)

description of formations encountered	from	to
TOP clay	0	20
Blue clay	0	260
Chalk	260	740
SAND	740	800

WELL LOCATION:
sec. 9 T 10 N R 4 E
S E of Pontotoc
(distance) miles (direction) of (nearest town)

WELL PURPOSE: HOME
(home, irrigation, municipal, industrial)


- WELL COMPLETION DATA:
- (1) diameter (inches) 4
 - (2) total depth (feet) 800
 - (3) static water level (feet) 210 below top of ground.
 - (4) casing STEEL 42 (material), (depth), 6" (size) if telescope see back.
 - (5) screen slotted pipe 400' (length), (depth to top), 2" (size), STEEL (material)
 - (6) pump 1 (HP), 10 (yield gpm), Elec (type power)
 - (7) electric log (yes or no)
 - (organization running log)
 - (8) how well bottom plugged CAP

DRILLERS REMARKS:

RECEIVED
APR 18 1985
Department of Natural Resources
Bureau of Land & Water Resources

If well telescopes please sketch and show depths.

GROUND LEVEL

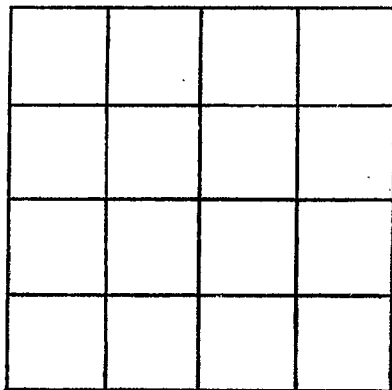

SECTION _____

Please indicate well location X.

ADDITIONAL INFORMATION

If more than one screen, show locations of each on sketch.