

PONTIAC
HOOVER

MISSISSIPPI
 BOARD OF WATER COMMISSIONERS
 416 North State Street
 Jackson, Mississippi 39201

WATER WELL DRILLERS LOG

Sept. 19 89
 date well completed

LEEDER Drilling
 firm name

PONTIAC
 county well located

LANDOWNER: PAUL BASS, JR.

description of formations encountered

from

to

RT 3 Pontiac MS

38463

(mailing address)

TOP CLAY

0

10

RED SAND

10

20

BLUE CLAY

20

30

CHALK

30

400

SILT + CLAY

400

610

SAND

610

710

WELL LOCATION:

sec. 23 T 10 N R 4 E
 9 miles SE of Pontiac
 (distance) (direction) (nearest town)

WELL PURPOSE: HOME
 (home, irrigation, municipal, industrial)

WELL COMPLETION DATA:

- (1) diameter (inches) 4"
- (2) total depth (feet) 710 LT
- (3) static water level (feet) 140 below above top of ground.
- (4) casing PVC 40 (material) (depth)
 4 1/2" (size) If telescope see back.
- (5) screen Cotton slotted P.P. 360 (length) (depth to top)
 2" (size) Steel (material)
- (6) pump 1 10 (HP) (yield gpm)
 Electric (type power)
- (7) electric log NO (yes or no)
 (organization running log)
- (8) how well bottom plugged BACK -
 Watch valves

RECEIVED
 RECEIVED
 RECEIVED


NOV 07 1989

Department of Natural Resources
 Bureau of Land & Water Resources

DRILLERS REMARKS:

If well telescopes please sketch and show depths.

GROUND LEVEL

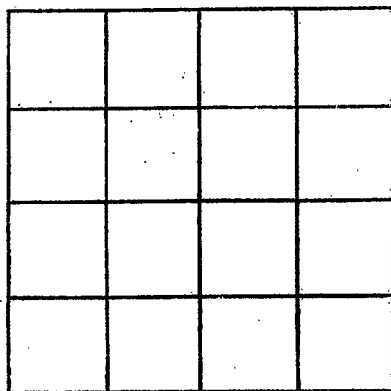

SECTION _____

Please indicate well location X.

ADDITIONAL INFORMATION

If more than one screen, show locations of each on sketch.