

MISSISSIPPI DEPARTMENT OF ENVIRONMENTAL QUALITY
Bureau of Land and Water Resources

P. O. Box 10631
Jackson, MS 39289-0631
WATER WELL DRILLERS LOG

COUNTY WELL LOCATED Pontotoc	
WELL NUMBER 7	CODED
H 2005	
DATE WELL COMPLETED 02/11/97	

PERMIT NUMBER
NAME OF DRILLING FIRM HERNDON WELL & SUPPLY
SHANNON, MS

NAME & MAILING ADDRESS OF LANDOWNER JAMES T. ROBBINS		
ROBBINS ST		
AMORY, MS 38821		
WELL LOCATION: SEC	TOWNSHIP	RANGE
32	10	S 4
DISTANCE	DIRECTION	NEAREST TOWN
5 Miles	SE	of Pontotoc
OTHER LANDMARK		
WELL PURPOSE: Home, Irrigation, Municipal, Industrial, Fish Pond, etc. home		

PUMP DATA		
PUMP TYPE (Circle One): Submersible , Turbine, Jet, Flowing Well, Other (Describe) _____		
POWER TYPE (Circle One): Electric, Tractor, Diesel, Gasoline, Butane, Other (Describe) _____ H/P 1 1/2		
Pump Capacity (GPM) 10	No. of Stages 21	Setting Depth 315 FT.
PUMP TEST		
Well yielded _____ GPM with a drawdown of _____ ft. after _____ hours of pumping		

WELL DATA		
Well Depth 966'	Casing Diameter (In.) 5"	Casing Length (Ft.) 507'
Type of Casing Steel	Hole Depth 966'	Depth to Static Water Level 230' approx
TYPE OF COMPLETION: (Circle One or More): Gravel Packed , Underreamed, Telescoped, Natural Development, Open Hole, Other		
Top of Lap Pipe or Reduction in Casing 483 FEET IF TELESCOPED OR MORE THAN ONE SCREEN: USE BACK PAGE		

LOG DATA	
TYPE OF LOG RUN (Circle One): Electric, Gamma Ray, Density, Sonic, Neutron, Other (Describe) _____ No Log Run	
Name of Organization Running Log	

SCREEN DATA		
Diameter - Inches 2"	Length - Feet 40'	Slot Size - Inches .010
Screen Type SS Ribbed		Depth to Bottom - Feet 966'

GEOLOGIC DATA (Office Use Only)			
Surface Elev.	Geologic Unit	Unit Thickness	Depth to Top
Subs. SWL	Date	Analysis	Aquifer Test


Driller's Remarks

DESCRIPTION OF FORMATIONS ENCOUNTERED	FROM	TO
Red Clay	0	6
Blue Clay	6	725
Sand	725	960
Blue Clay	960	970

FORMATIONS (Continued)	FROM	TO
RECEIVED		
FEB 14 1997		
Dept. of Environmental Quality Office of Land & Water Resources		
IF MORE SPACE IS NEEDED, USE BACK		

If well telescopes please sketch and show depths.

GROUND LEVEL

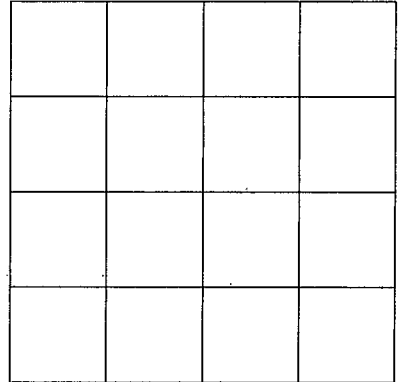

SECTION _____

Please indicate well location X.

ADDITIONAL INFORMATION

If more than one screen,
show location of each on sketch.