

MISSISSIPPI DEPARTMENT OF ENVIRONMENTAL QUALITY

Office of Land and Water Resources

P. O. Box 10631
Jackson, MS 39289-0631

WATER WELL DRILLERS LOG

COUNTY WELL LOCATED
Pontotoc

WELL NUMBER
A-2007

CODED

DATE WELL COMPLETED
6-3-02

PERMIT NUMBER

NAME OF DRILLING FIRM
Tim's Well & Pump
SVC

NAME & MAILING ADDRESS OF LANDOWNER
Brian Sullivan

Pontotoc MS

Latitude:

Longitude:

WELL LOCATION. SEC **5** TOWNSHIP **10 N** RANGE **4 E**

DISTANCE **3** Miles DIRECTION **E** of NEAREST TOWN **Pontotoc**

OTHER LANDMARK
across Hwy 6 from Golf course

WELL PURPOSE (Home Irrigation, Municipal, Industrial, Fish Pond, etc.)

PUMP DATA

PUMP TYPE (Circle One):
 Submersible, Turbine, Jet, Flowing Well,
Other (Describe)

POWER TYPE (Circle One):
 Electric, Tractor, Diesel, Gasoline, Butane,
Other (Describe) **H/P 1.5**

DESCRIPTION OF FORMATIONS ENCOUNTERED	FROM	TO
Top Soil	0	4
Clay	4	23
(Sand)	27	30
Clay (chalky)	30	520
Dark grey clay	520	645
fine sand	645	715

WELL DATA

Well Depth **715** Casing Diameter (In.) **4** Casing Length (Ft.) **300**

Type of Casing **PVC** Hole Depth **715** Depth to Static Water Level **180**

TYPE OF COMPLETION: (Circle One or More):
Gravel Packed, Underreamed, Telescoped,
Natural Development, Open Hole, Other

WELL GROUTED TO A DEPTH OF **20** FEET
Type Grout (circle one): Cement, Bentonite, or Mix

SCREEN DATA

Diameter - Inches **2** Length - Feet **50** Slot Size - Inches **1008**

Screen Type **PVC** Depth to Bottom - Feet **715**

RECEIVED
JUN 26 2002
BY: OLWR

Top of Lap Pipe or Reduction in Casing

FEET IF TELESCOPED OR MORE THAN ONE SCREEN: USE BACK PAGE


I certify that the well was drilled, constructed and completed in accordance with all applicable Requirements of the Mississippi Department of Environmental Quality and/or the Mississippi Department of Health regulations and state laws.

Tom Baker
Signature of Licensed Driller and License No.

6-23-02
Date

Additional Information Required On Back

If well telescopes please sketch and show depths.

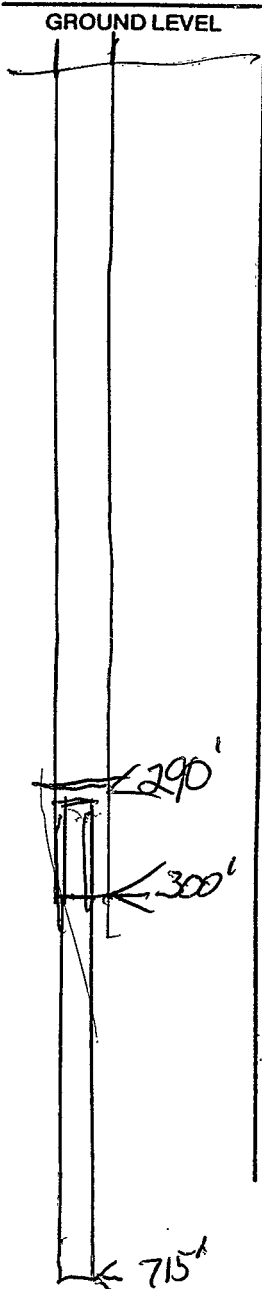

If more than one screen, show location of each on sketch.

			X

SECTION 5

Please indicate well location X.

Pump Capacity (GPM)	No. of Stages	Setting Depth	FT.
---------------------	---------------	---------------	-----

PUMP TEST

Well yielded _____ GPM with a drawdown of _____ ft. after _____ hours of pumping

LOG DATA

TYPE OF LOG RUN (Circle One): No Log Run, Electric, Gamma Ray, Density, Sonic, Neutron, Other (Describe) _____

Name of Organization Running Log _____

GEOLOGIC DATA (Office Use Only)

Surface Elev.	Geologic Unit	Unit Thickness	Depth to Top
Subs. SWL	Date	Analysis	Aquifer Test

Driller's Remarks
