

PONTOTOC

J 11

2-4-74

MISSISSIPPI
 BOARD OF WATER COMMISSIONERS
 416 North State Street
 Jackson, Mississippi 39201

CODED

WATER WELL DRILLERS LOG

2-4

1974

Leiper

Pontotoc

date well completed

firm name

county well located

LANDOWNER:

Mickey McKnight
 Rt 4 - Pontotoc
 (mailing address)

description of formations encountered

	from	to
Buckshot + Clay	0	40
R (Clay + Rock)	40	80
Blue Clay -	80	126
Blue Clay + Rock	126	200
Rock + Chalk	200	300
Sand -	300	450

WELL LOCATION:

sec. 12 T 11 N R 1 E
 14 miles SW of Pontotoc
 (distance) (direction) (nearest town)

WELL PURPOSE: Home
 (home, irrigation, municipal, industrial)

WELL COMPLETION DATA:

- (1) diameter (inches) 4
- (2) total depth (feet) 450
- (3) static water level (feet) 80 below top of ground.
- (4) casing Steel 126
 (material) (depth)

CODED

(size) if telescope see back.

- (5) screen none
 (length) (depth to top)

- (6) pump 3/4 9
 (HP) (yield gpm)

Elect
(type power)

- (7) electric log no -
 (yes or no)

(organization running log)

- (8) how well bottom plugged open


RECEIVED
 MAR 21 1974

DRILLERS REMARKS:

MISS. BD. OF WATER COMM

If well telescopes please sketch and show depths.

GROUND LEVEL

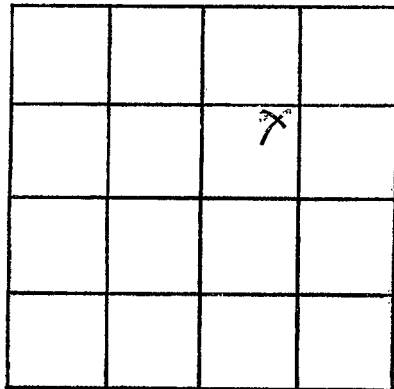

SECTION 12

Please indicate well location X.

ADDITIONAL INFORMATION

If more than one screen,
show locations of each on sketch.