

MISSISSIPPI DEPARTMENT OF NATURAL RESOURCES

Bureau of Land and Water Resources

Southport Mall

P.O. Box 10631

Jackson, Mississippi 39209

WATER WELL DRILLERS LOG

Pontotoc
J2000

7/27 1982
date well completed

Ceeper Drilling
firm name

Pontotoc
county well located

LANDOWNER:	description of formations encountered	from	to
<u>Raymond Austin</u> <u>Rt 1 Randolph Ms.</u> (mailing address)			
	<u>Blue clay</u>	<u>20</u>	<u>280</u>
	<u>Chalk</u>	<u>280</u>	<u>480</u>
	<u>SAND</u>	<u>480</u>	<u>525</u>
WELL LOCATION: sec. <u>27</u> T. <u>11</u> N. R. <u>1</u> E. <u>Buckhorn Community</u> (distance) miles (direction) of (nearest town)			
WELL PURPOSE: <u>HOME</u> (home, irrigation, municipal, industrial)			
WELL COMPLETION DATA:			
(1) diameter (inches) <u>4</u>			
(2) total depth (feet) <u>525</u>			
(3) static water level (feet) <u>90</u> ^{below} _{above} top of ground			
(4) casing <u>PVC</u> <u>505</u> (material) (depth)			
<u>4"</u> (size) if telescope see back.			
(5) screen <u>20'</u> <u>505</u> (length) (depth to top)			
<u>4"</u> <u>PVC</u> (size) (material)			
(6) pump <u>3/4</u> <u>10</u> (HP) (yield gpm)			
<u>electric</u> (type power)			
(7) electric log <u>NO</u> (yes or no)			
<u></u> (organization running log)			
(8) how well bottom plugged <u>cap</u>			
DRILLERS REMARKS:			


DEPT. OF NATURAL RESOURCES
BUREAU OF LAND & WATER RESOURCES

APR 28 1982

RECEIVED

If well telescopes please sketch and show depths.

GROUND LEVEL

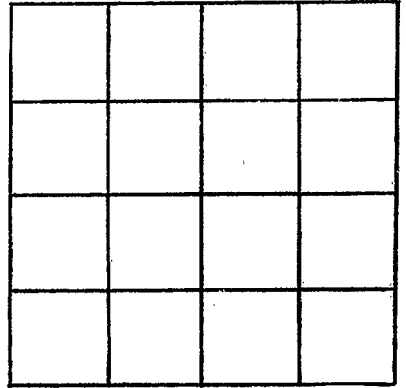

SECTION _____

Please indicate well location X.

ADDITIONAL INFORMATION

If more than one screen, show locations of each on sketch.