

Pontotoc
8 2001.

MISSISSIPPI
BOARD OF WATER COMMISSIONERS
416 North State Street
Jackson, Mississippi 39201

WATER WELL DRILLERS LOG

October 1984
date well completed

Leeper Drilling
firm name

Pontotoc
county well located

LANDOWNER:
Mattie Washington
Rt 1 Randolph Ms.
(mailing address)

description of formations encountered	from	to
TOP CLAY	0	20
Blue clay	20	240
Chalk	240	400
SAND	400	460

WELL LOCATION:
sec 25 T 11 N R 1 E
Buckhorn Community
(distance) (direction) (nearest town)

WELL PURPOSE:
(home, irrigation, municipal, industrial)


- WELL COMPLETION DATA:
- (1) diameter (inches) 4"
 - (2) total depth (feet) 460'
 - (3) static water level (feet) 100 ^{below}/_{above} top of ground.
 - (4) casing PVC, 260',
(material) (depth)
4" if telescope see back.
(size)
 - (5) screen NONE,
(length) (depth to top)
(size) (material)
 - (6) pump 3/4 10
(HP) (yield gpm)
Electric
(type power)
 - (7) electric log No
(yes or no)
(organization running log)
 - (8) how well bottom plugged OPEN

DRILLERS REMARKS:

DEPT. OF NATURAL RESOURCES
BUREAU OF LAND & WATER RESOURCES
NOV 29 1984
RECEIVED

If well telescopes please
sketch and show depths.

GROUND LEVEL

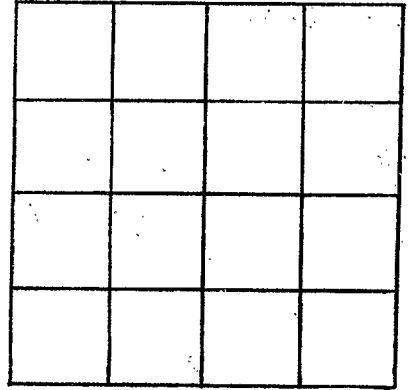

SECTION _____

Please indicate well location X.

ADDITIONAL INFORMATION

If more than one screen,
show locations of each on sketch.