

MISSISSIPPI DEPARTMENT OF NATURAL RESOURCES
 Bureau of Land and Water Resources
 Southport Mall
 P.O. Box 10631
 Jackson, Mississippi 39209
WATER WELL DRILLERS LOG

PONTOTOC
 J 2000

DEC 1986 Leeper Drilling Pontotoc
 date well completed firm name county well located

LANDOWNER: DAN BARNES
 RT 1 Randolph, MS
 (mailing address)

WELL LOCATION:
 sec. 26 T 11 N R. 1 E
 14 miles SW of PONTOTOC
 (distance) (direction) (nearest town)

WELL PURPOSE: HOME
 (home, irrigation, municipal, industrial)

- WELL COMPLETION DATA:
- (1) diameter (inches) 4"
 - (2) total depth (feet) 500'
 - (3) static water level (feet) 90' ^{below} above top of ground.
 - (4) casing PVC 200'
 (material) (depth)
 4" if telescope see back.
 (size)
 - (5) screen NONE
 (length) (depth to top)
 (size) (material)
 - (6) pump 1 10
 (HP) (yield gpm)
 ELEC
 (type power)
 - (7) electric log NO
 (yes or no)
 (organization running log)
 - (8) how well bottom plugged OPEN

| description of formations encountered | from | to |
|---------------------------------------|------|-----|
| Top Clay | 0 | 20 |
| Blue Clay | 20 | 350 |
| CHALK | 350 | 450 |
| SAND | 450 | 500 |
| | | |
| | | |
RECEIVED


DEC 24 1986

Department of Natural Resources
 Bureau of Land & Water Resources

DRILLERS REMARKS:

If well telescopes please
sketch and show depths.

GROUND LEVEL

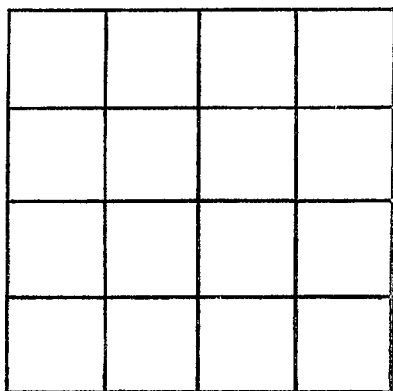

SECTION _____

Please indicate well location X.

ADDITIONAL INFORMATION

If more than one screen,
show locations of each on sketch.