

PONTOTOC
J 2004

MISSISSIPPI
BOARD OF WATER COMMISSIONERS
416 North State Street
Jackson, Mississippi 39201

WATER WELL DRILLERS LOG

Sept 1986 Leeper Drilling Pontotoc
date well completed firm name county well located

LANDOWNER: JAMES Bramlett
RT 1 Randolph MS

(mailing address)

WELL LOCATION:
sec. 16 T. 11 N. R. 1 (E)
(S)
17 miles SW of Pontotoc
(distance) (direction) (nearest town)

description of formations encountered	from	to
<u>TOP CLAY</u>	<u>0</u>	<u>20</u>
<u>Blue clay</u>	<u>20</u>	<u>350</u>
<u>Chalk</u>	<u>350</u>	<u>580</u>
<u>SAND</u>	<u>580</u>	<u>620</u>

WELL PURPOSE:
(home) irrigation, municipal, industrial

WELL COMPLETION DATA:
(1) diameter (inches) 4"
(2) total depth (feet) 620 ft
(3) static water level (feet) 190 below top of ground.
(4) casing PVC 300 ft
(material) (depth)
4" If telescope see back.
(size)
(5) screen _____
(length) (depth to top)
(size) (material)
(6) pump 1 7
(HP) (yield gpm)
elec
(type power)
(7) electric log NO
(yes or no)
(organization running log)
(8) how well bottom plugged OPEN


RECEIVED
NOV 12 1986

Department of Natural Resources
Bureau of Land & Water Resources

DRILLERS REMARKS:

If well telescopes please sketch and show depths.

GROUND LEVEL

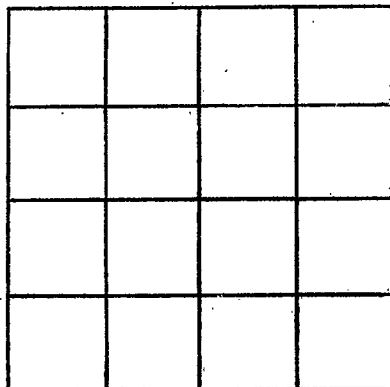

SECTION _____

Please indicate well location X.

ADDITIONAL INFORMATION

If more than one screen,
show locations of each on sketch.