

PONTIAC
I
2007

MISSISSIPPI
BOARD OF WATER COMMISSIONERS
416 North State Street
Jackson, Mississippi 39201

WATER WELL DRILLERS LOG

June 1988 LEEPER Drilling Pontiac
date well completed firm name county well located

LANDOWNER: Terry Vaughn RT 1, Randolph, MS	description of formations encountered	from	to
(mailing address)	TOP CLAY	0	20
WELL LOCATION: sec. 35 T 11 N R 1 E 12 miles SW of Pontiac (distance) (direction) (nearest town)	BLUE CLAY	20	250
WELL PURPOSE: HOME (home, irrigation, municipal, industrial)	CHALK	250	350
WELL COMPLETION DATA: (1) diameter (inches) 4" (2) total depth (feet) 410 (3) static water level (feet) 80 below top of ground (4) casing PVC 200' (material) (depth) 4" (size) if telescope see back. (5) screen NONE (length) (depth to top) (size) (material) (6) pump 1 (HP) 10 (yield gpm) Elec (type power) (7) electric log NO (yes or no) (organization running log) (8) how well bottom plugged OPEN	SAND	350	410
DRILLERS REMARKS:			


RECEIVED

AUG 11 1988

Department of Natural Resources
Bureau of Land & Water Resources

If well telescopes please sketch and show depths.

GROUND LEVEL

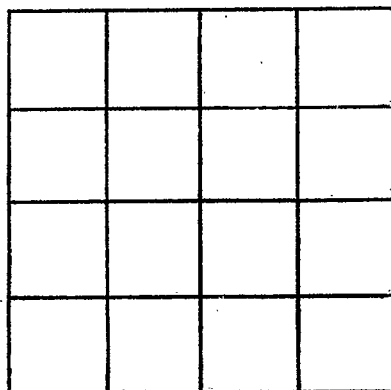

SECTION _____

Please indicate well location X.

ADDITIONAL INFORMATION

If more than one screen,
show locations of each on sketch.