

K-5

7-14-60

WATER WELL DRILLERS LOG

K CODED

Date: 7-14, 1960, Driller: J. L. Mikes County: Pontotoc  
(Name)

**OWNER**

(1) Owner of Land: J. L. Mikes  
(Name)

Pontotoc, P. O. Box 15  
(Address)

(2) Location: East half Section  
1/4, 1/4, Sec 20 T. 12 R.  
8 miles North of Monroe  
(distance) (direction) (Nearest Town)

(3) Topography: 1/2 flat  
(Hilly) (Flat) (Level)

(4) Purpose of Well: Domestic  
(Domestic Irrigation Municipal, Industrial, Other)

Description & Color of Materials Sand, Clay, Red Clay, Shell, etc.	Thick-ness Feet	Depth Feet
<u>soil &amp; jointing clay</u>	<u>30</u>	<u>30</u>
<u>black shale</u>	<u>115</u>	<u>150</u>
<u>Blue sandy cone rock</u>	<u>200</u>	<u>350</u>
<u>rock &amp; sand</u>	<u>80</u>	<u>430</u>


Information upon completion of well:

- (1) Diameter: 4 inches.
- (2) Total Depth: 430 feet.
- (3) Water Level: 55 feet below top of ground.
- (4) Cased to 44, Size H 1"
- (5) Screen: Size \_\_\_\_\_, Length \_\_\_\_\_
- (6) Were any formations sealed against pollution?  
\_\_\_\_\_ yes, \_\_\_\_\_ no.

If YES depth of formation \_\_\_\_\_

Why \_\_\_\_\_

Drillers Remarks: \_\_\_\_\_

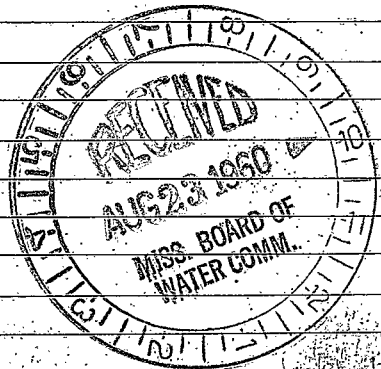

(Use Back Side)

Well No. L301

