

PONTOTOC MISSISSIPPI BOARD OF WATER COMMISSIONERS

K-6  
7-27-60

WATER WELL DRILLERS LOG **CODED** 801

Date: 7-27 19 60, Driller: J & Markey County Pontotoc  
(Name)

(1) Owner of Land: John Moss  
(Name)  
Houlka RFD  
(Address)  
(2) Location: SW 1/4, T6 N, Sec. 29, T18 N, R3 E  
9 miles west of Houlka  
(distance) (direction) (Nearest Town)  
(3) Topography: flat  
(Hilly) (Flat) (Level)  
(4) Purpose of Well: Domestic  
(Domestic Irrigation, Municipal, Industrial, Other)


| Description & Color of Materials<br>Sand, Clay, Red Clay, Shell, etc. | Thick-<br>ness<br>Feet | Depth<br>Feet |
|---|------------------------|---------------|
| <u>Soft fine clay</u>   | <u>35</u>              | <u>35</u>     |
| <u>black shale</u>  | <u>120</u>             | <u>155</u>    |
| <u>Blue marl some rock</u>  | <u>678</u>             | <u>325</u>    |
| <u>rock &amp; sand</u>  | <u>45</u>              | <u>370</u>    |

Information upon completion of well:

(1) Diameter 4 inches.  
(2) Total Depth 370 feet.  
(3) Water Level 45 feet below top of ground.  
(4) Cased to 4 1/2', Size 4 1/2"  
(5) Screen: Size \_\_\_\_\_, Length \_\_\_\_\_  
(6) Were any formations sealed against pollution?  
\_\_\_\_\_ yes, \_\_\_\_\_ no.

If YES depth of formation \_\_\_\_\_  
Why \_\_\_\_\_  
Drillers Remarks: \_\_\_\_\_

**CODED**

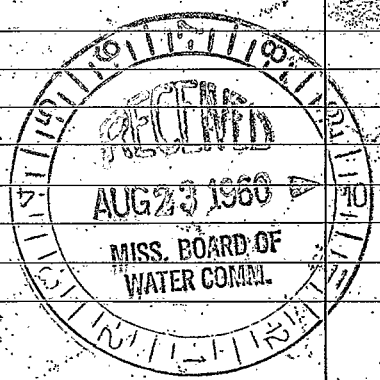

(Use Back Side)

Well No.  
1501

