

CODED

CODED

MISSISSIPPI
BOARD OF WATER COMMISSIONERS
416 North State Street
Jackson, Mississippi 39201

WATER WELL DRILLERS LOG

Pontotoc
K-7
10-67

10-26-67 1967 LAMAR WILDER PONTOTOC
date well completed firm name county well located

LANDOWNER:

LAWRENCE LANTRIP

(mailing address)

WELL LOCATION:

sec. 3 T. 11 N. R. 2 E
S. 9 miles SW of Pontotoc
(distance) (direction) (nearest town)

WELL PURPOSE: DAILY
(home, irrigation, municipal, industrial)

WELL COMPLETION DATA:

- (1) diameter (inches) 4" OVER 6"
- (2) total depth (feet) 566
- (3) static water level (feet) 147 below top of ground.
- (4) casing 4" (material), 147' (depth)

 if telescope see back.
(size)

- (5) screen 40' (length), 526' (depth to top)
STAINLESS (material)

- (6) pump 1 1/2 (HP), 800 GPM (yield gpm)
ELECTRIC (type power)

- (7) electric log NO (yes or no)

(organization running log)

- (8) how well bottom plugged

DRILLERS REMARKS:

description of formations encountered

from to

GREY BUCKSLOTT

0 35

BLUE SHALE

35 180

ROCK & SAND

180 250

BLUE SHALE

250 400


ROCK & SAND

400 550

BLUE SHALE


550 566

CODED

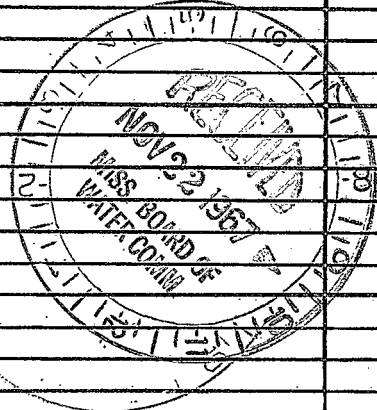

If well telescopes please sketch and show depths.

GROUND LEVEL

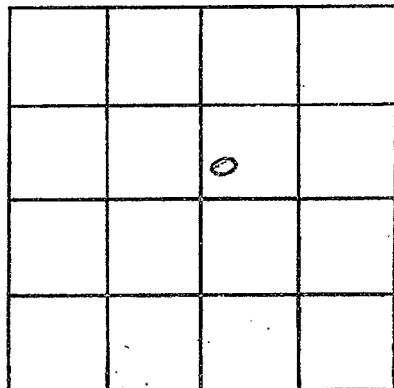

SECTION _____

Please indicate well location X.

ADDITIONAL INFORMATION

If more than one screen, show locations of each on sketch.