

Pontotoc
K-8
6-68

MISSISSIPPI
BOARD OF WATER COMMISSIONERS
416 North State Street
Jackson, Mississippi 39201

CODED

WATER WELL DRILLERS LOG

JUNE 20 19 68 LAMAR WILGER PONTOTOC
date well completed firm name county well located

LANDOWNER:

JAMES BROWN
AUGA MISS
(mailing address)

description of formations encountered

from to

ROCKSNOT	0	18
BLUE SHALE	18	320
BLACK SAND	320	335

WELL LOCATION:

sec. 19 T. 11 S. R. 2 E
miles of (distance) (direction) (nearest town)

WELL PURPOSE:

(home, irrigation, municipal, industrial)

WELL COMPLETION DATA:

- diameter (inches) 4
- total depth (feet) 435
- static water level (feet) 90 below top of ground.
- casing STEEL 118 (material) (depth) 4" (size) if telescope see back.
- screen (length) (depth to top) (size) (material)
- pump 3/4 (HP) 5 (yield gpm)
- electric log NO (yes or no) (organization running log)
- how well bottom plugged


CODED

JUL 8 1968
MISS. BOARD OF
WATER COMMISSIONERS

DRILLERS REMARKS:

If well telescopes please sketch and show depths.

GROUND LEVEL

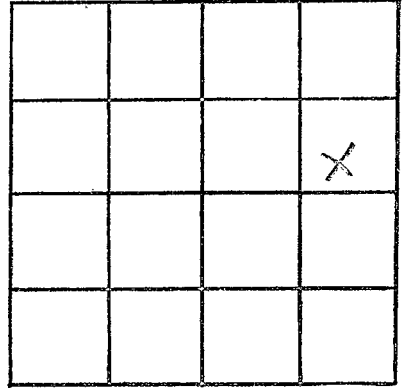

SECTION _____

Please indicate well location X.

ADDITIONAL INFORMATION

If more than one screen,
show locations of each on sketch.