

Pontotoc  
K-9  
7-68

MISSISSIPPI  
 BOARD OF WATER COMMISSIONERS  
 416 North State Street  
 Jackson, Mississippi 39201

**CODED**

WATER WELL DRILLERS LOG

7-3 1968 Clark Bros. Pontotoc  
 date well completed firm name county well located

LANDOWNER: James S. Allen  
Route 5  
Pontotoc, Miss.  
 (mailing address)

| description of formations encountered | from       | to         |
|---------------------------------------|------------|------------|
| <u>Shale</u>                          | <u>0</u>   | <u>30</u>  |
| <u>Rock</u>                           | <u>30</u>  | <u>70</u>  |
| <u>Blue mud</u>                       | <u>70</u>  | <u>130</u> |
| <u>Rock</u>                           | <u>130</u> | <u>150</u> |
| <u>Blue mud</u>                       | <u>150</u> | <u>170</u> |
| <u>Rock &amp; Sand</u>                | <u>170</u> | <u>200</u> |

WELL LOCATION:  
 sec. 10 T. 11 N. R. 2 E  
10 miles S of Pontotoc  
 (distance) (direction) (nearest town)

WELL PURPOSE: Home  
 (home, irrigation, municipal, industrial)

WELL COMPLETION DATA:

- diameter (inches) 4"
- total depth (feet) 200
- static water level (feet) 45' below above top of ground.
- casing Metal, 84'  
 (material) (depth)  
4"  
 (size) if telescope see back.
- screen None  
 (length) (depth to top)  
 (size) (material)
- pump 3/4 Sub. 15  
 (HP) (yield gpm)  
Electric  
 (type power)
- electric log no  
 (yes or no)  
 (organization running log)
- how well bottom plugged no


**CODED**

JUL 23 1968  
 MISS. BOARD OF  
 WATER COMM.

DRILLERS REMARKS:

If well telescopes please sketch and show depths.

GROUND LEVEL

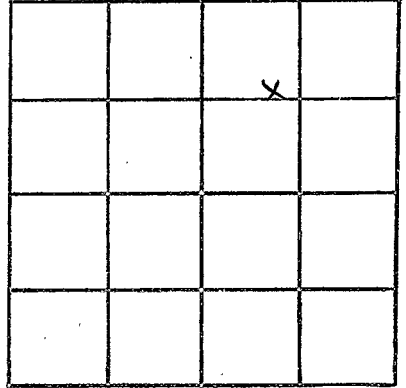

SECTION \_\_\_\_\_

Please indicate well location X.

ADDITIONAL INFORMATION

If more than one screen, show locations of each on sketch.