

CODED

CODED

MISSISSIPPI
BOARD OF WATER COMMISSIONERS
416 North State Street
Jackson, Mississippi 39201

WATER WELL DRILLERS LOG

Pontotoc
K10
1-18-68
1-18-68 19 Yering Gass Co
date well completed firm name

Pontotoc
county well located

LANDOWNER:
Fitts Farms
Pontotoc MS 3
(mailing address)

description of formations encountered	from	to
<u>Joint clay</u>	<u>0</u>	<u>50</u>
<u>Blue</u>	<u>50</u>	<u>200</u>
<u>Gray Sand + Rock</u>	<u>200</u>	<u>300</u>
<u>Sand</u>	<u>275</u>	<u>435</u>

WELL LOCATION:
sec. 10 T. 11 N. R. 2 E
12 miles SW of Pontotoc
(distance) (direction) (nearest town)

WELL PURPOSE: Home
(home, irrigation, municipal, industrial)

WELL COMPLETION DATA:

(1) diameter (inches) 5"

(2) total depth (feet) 431'

(3) static water level (feet) 180' below above top of ground.

(4) casing EP 220 (material) (depth)

_____ if telescope see back. (size)

(5) screen _____ (length) (depth to top)

_____ (size) _____ (material)

(6) pump 3/4 680 (HP) (yield gpm)

EP 220 (type power)

(7) electric log _____ (yes or no)

_____ (organization running log)

(8) how well bottom plugged _____


CODED

FEB 13 1968
MISS. Bd. OF WATER COMMISSIONERS

DRILLERS REMARKS:

If well telescopes please sketch and show depths.

GROUND LEVEL

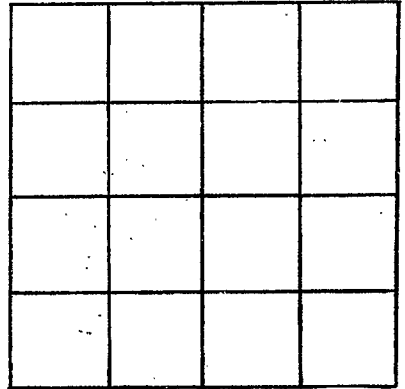

SECTION 10

Please indicate well location X.

ADDITIONAL INFORMATION

If more than one screen, show locations of each on sketch.