

CODED

MISSISSIPPI
BOARD OF WATER COMMISSIONERS
416 North State Street
Jackson, Mississippi 39201

Pontotoc
R 11.
12-18-69

WATER WELL DRILLERS LOG

12-18 1969 Clark Bros Pontotoc
date well completed firm name county well located

LANDOWNER:
Mike Day
Pontotoc
(mailing address)

description of formations encountered	from	to
Gravel	0	20
Rock & Sand	20	80
Blue mud	80	130
Rock Sand	130	242

WELL LOCATION:
sec. 7 T 11 N R 2 E
12 miles S of Pontotoc
(distance) (direction) (nearest town)

WELL PURPOSE: Home
(home, irrigation, municipal, industrial)

- WELL COMPLETION DATA:
- (1) diameter (inches) 4"
 - (2) total depth (feet) 242'
 - (3) static water level (feet) 60 below top of ground.
 - (4) casing metal, 90' (material) (depth)
4" (size) if telescope see back.
 - (5) screen None (length) (depth to top)
 - (6) pump 1 1/2 (HP) 2 (yield gpm)
Electric (type power)
 - (7) electric log no (yes or no)
 - (8) how well bottom plugged no

242'
130'
11'


JAN - 5 1970

DRILLERS REMARKS:

MISSISSIPPI
BOARD OF WATER COMMISSIONERS

If well telescopes please sketch and show depths.

GROUND LEVEL

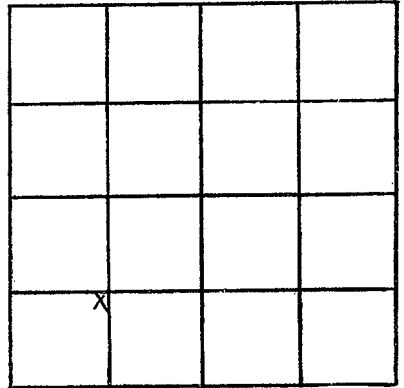

SECTION 7

Please indicate well location X.

ADDITIONAL INFORMATION

If more than one screen, show locations of each on sketch.