

Pontotoc
K-13
7-68

MISSISSIPPI
 BOARD OF WATER COMMISSIONERS
 416 North State Street
 Jackson, Mississippi 39201

CODED

WATER WELL DRILLERS LOG

date well completed 19 68 Clark Bros. firm name Pontotoc county well located

LANDOWNER Lannie McKnight

Description of formations encountered

from

to

Route 5

Shumbo
Rock

0 30

Pontotoc

Blue mud
Rock

30 70

(mailing address)

WELL LOCATION:

sec. 10 T. 11 N. R. 2 E.
10 miles S of Pontotoc
 (distance) (direction) (nearest town)

Blue mud
Rock & Sand

130 150

150 170

170 200

WELL PURPOSE: Home
 (home, irrigation, municipal, industrial)

WELL COMPLETION DATA:

- (1) diameter (inches) 4"
- (2) total depth (feet) 200'
- (3) static water level (feet) 45' below above top of ground.
- (4) casing metal, 84'
 (material), (depth)
4" if telescope see back.
 (size)
- (5) screen None
 (length) (depth to top)
 (size) (material)
- (6) pump 3/4 jet, 8
 (HP) (yield gpm)
Electric
 (type power)
- (7) electric log NO
 (yes or no)
 (organization running log)
- (8) how well bottom plugged NO

CODED


JUL 23 1968

MISS. BOARD OF
 WATER COMMISSIONERS

DRILLERS REMARKS:

If well telescopes please sketch and show depths.

GROUND LEVEL

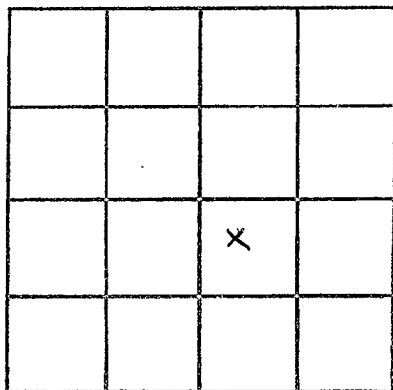

SECTION _____

Please indicate well location X.

ADDITIONAL INFORMATION

If more than one screen, show locations of each on sketch.