

PONTOTOC MISSISSIPPI BOARD OF WATER COMMISSIONERS

K 14

4-26-62

WATER WELL DRILLERS LOG

CODED

Date: 4-26, 1962, Driller: CFCARLIS County WILSON
(Name)

(1) Owner of Land: RC BRADY
(Name)

ALGOMA MISS.
(Address)

(2) Location: 1/4, 1/4, Sec. 11 T11 R2

5 miles SOUTH of ALGOMA
(distance) (direction) (Nearest Town)

(3) Topography: _____
(Hilly) (Flat) (Level)

(4) Purpose of Well: DOMESTIC
(Domestic Irrigation
Municipal, Industrial, Other)

Description & Color of Materials Sand, Clay, Red Clay, Shell, etc.	Thick- ness Feet.	Depth Feet
WHITE DIRT	20	
ROCK & SOFT		
ROCK	40	60
LIME ROCK	80	140
WATER "	4	144
" SAND	37	173

Information upon completion of well:

(1) Diameter 4 inches.

(2) Total Depth 173 feet.

(3) Water Level 30 feet below top of ground.

(4) Cased to 84, Size 4

(5) Screen: Size _____, Length _____

(6) Were any formations sealed against pollution?


_____ yes, _____ no.

If YES depth of formation _____

Why _____

Drillers Remarks: _____

CODED

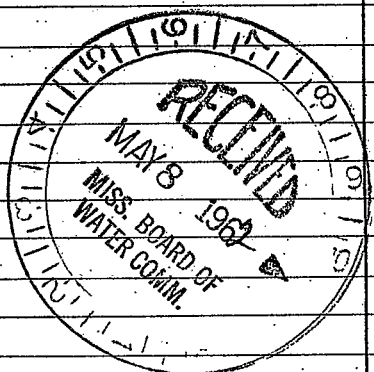

27

Well No.

(Use Back Side)

1942

1942

