

K15

2-20-64

WATER WELL DRILLERS LOG

CODED

Date: 2-20, 1964, Driller: C F CARLISLE County: UNION
(Name)

(1) Owner of Land HENRY WAGGS
(Name)
ALBOMA MISS R.I.
(Address) 36 10 1

(2) Location: 1/4, 1/4, Sec. 28 T11R2
1/2 miles S, of ALBOMA
(distance) (direction) (Nearest Town)

(3) Topography: X
(Hilly) (Flat) (Level)

(4) Purpose of Well: DOMESTIC
(Domestic Irrigation) (Municipal, Industrial, Other)

Description & Color of Materials Sand, Clay, Red Clay, Shell, etc.	Thick- ness Feet	Depth Feet
<u>GUMBO</u>	<u>36</u>	<u>30</u>
<u>ROCK</u>	<u>40</u>	<u>70</u>
<u>BLUE DIRT</u>	<u>42</u>	<u>112</u>
<u>ROCK & SOFT ROCK</u>	<u>37</u>	<u>149</u>
<u>WATER SAND</u>	<u>21</u>	<u>170</u>

Information upon completion of well:

(1) Diameter 4 inches.

(2) Total Depth 170 feet.

(3) Water Level 30 feet below top of ground.

(4) Cased to 84, Size _____.

(5) Screen: Size _____, Length _____.


(6) Were any formations sealed against pollution?
_____ yes, _____ no.

If YES depth of formation _____

Why _____

Drillers Remarks: _____

CODED

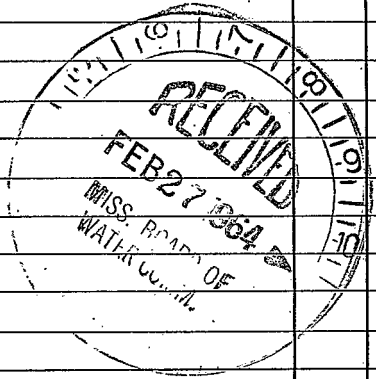

67 Well No.

(Use Back Side)

0101

0101