

Pontatoe
 R 16
 9-23-68

MISSISSIPPI
 BOARD OF WATER COMMISSIONERS
 416 North State Street
 Jackson, Mississippi 39201

WATER WELL DRILLERS LOG

CODED

9-23-1968 date well completed
 58 Ewing Bros. Co. firm name
 Pontatoe county well located

LANDOWNER: Carroll W. Ewing
 RT 1 Hulka, Miss.
 (mailing address)

description of formations encountered	from	to
Point Clay	0	80
Shale	80	140
Sandstone	140	239
Miss. Sandstone	239	307
Flint rock	307	327
Sand	327	393

WELL LOCATION:
 sec. 29 T 11 N R 2 E
 S W
2 1/2 miles W of Hulka
 (distance) (direction) (nearest town)

WELL PURPOSE: home
 (home, irrigation, municipal, industrial)

WELL COMPLETION DATA:

- (1) diameter (inches) 5
- (2) total depth (feet) 393
- (3) static water level (feet) 105 below above top of ground.
- (4) casing CR 85'
 (material) (depth)
 _____ if telescope see back.
 (size)
- (5) screen _____
 (length) (depth to top)

 (size) (material)
- (6) pump V3 450
 (HP) (yield gpm)
EP 220
 (type power)
- (7) electric log _____
 (yes or no)

 (organization running log)
- (8) how well bottom plugged _____

CODED


NOV 26 1968

MISS. Bd. of WATER COMMISSIONERS

DRILLERS REMARKS: 1 inch
around 309 sand
2 1/2 miles W of Hulka

If well telescopes please sketch and show depths.

GROUND LEVEL

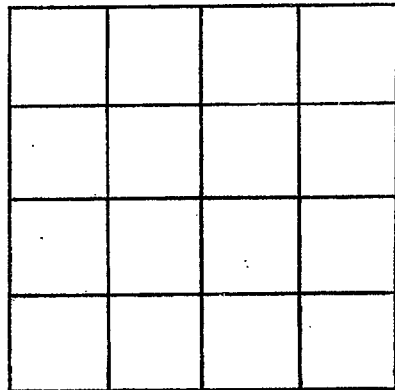

SECTION 29

Please indicate well location X.

ADDITIONAL INFORMATION

If more than one screen, show locations of each on sketch.