

MISSISSIPPI
BOARD OF WATER COMMISSIONERS
416 North State Street
Jackson, Mississippi 39201

CODED

WATER WELL DRILLERS LOG

PONTOTOC
K17
7-23-73

June 19 73 J. W. Webbsom Pontotoc
date well completed firm name county well located

LANDOWNER: Jones Hallaway
Pontotoc

description of formations encountered	from	to
soil	0	7
Mudstone	1	60
Blue Rock	60	347
Water Rock	347	348
Water Sand	348	445

(mailing address)

WELL LOCATION:

sec. 8 T. 7th N R. 20th W
9 11th S
(distance) miles South of Pontotoc (direction) (nearest town)

WELL PURPOSE:

(home, irrigation, municipal, industrial)

WELL COMPLETION DATA:

- (1) diameter (inches) 4"
- (2) total depth (feet) 445
- (3) static water level (feet) 141 below top of ground.
- (4) casing Steel, 42 ft. (material) (depth)
4" (size) if telescope see back.
- (5) screen 0 (length), 0 (depth to top)
(size) (material)
- (6) pump 1/2 HP Sub 8 (HP) (yield gpm)
8 elec (type power)
- (7) electric log (yes or no)
(organization running log)
- (8) how well bottom plugged

CODED


DRILLERS REMARKS: open

JUL 18 1973

MISS. BD. OF
WATER COMMISSIONERS

If well telescopes please sketch and show depths.

GROUND LEVEL

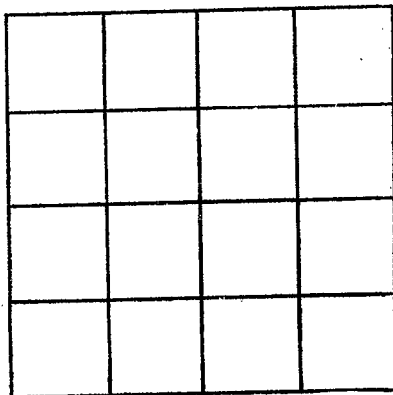

SECTION _____

Please indicate well location X.

ADDITIONAL INFORMATION

If more than one screen, show locations of each on sketch.