

MISSISSIPPI DEPARTMENT OF NATURAL RESOURCES

Bureau of Land and Water Resources

Southport Mall

P.O. Box 10631

Jackson, Mississippi 39209

WATER WELL DRILLERS LOG

CODED

Pontotoc
K 20

6-18 1987 T.M. Parks Drlg. Co. Pontotoc
 date well completed firm name county well located

LANDOWNER: Town of New
Houlka P.O. Box 192
Houlka, Ms. 38850
 (mailing address)

description of formations encountered	from	to
Top Soil	0	60
Chalk / Limestone	60	190
Sandy Shale	190	210
Shale / Limestone	210	340
Fine Sand / Shale	340	358
Sand Shale	358	410
Clays	410	420

WELL LOCATION:
 sec. 29 T. 11 N. R. 2 E
 (S) (W)
10 miles NW of Houlka
 (distance) (direction) (nearest town)

WELL PURPOSE: City
 (home, irrigation, municipal, industrial)

WELL COMPLETION DATA:

(1) diameter (inches) 14"

(2) total depth (feet) 420'

(3) static water level (feet) 104 below above top of ground.

(4) casing US Steel 358'
 (material) (depth)
10 3/4" if telescope see back.
 (size)

(5) screen 30' 360'
 (length) (depth to top)
4" Stainless
 (size) (material)

(6) pump 25 200
 (HP) (yield gpm)
30
 (type power)

(7) electric log Yes
 (yes or no)
MGS
 (organization running log)

(8) how well bottom plugged BPV

CODED

RECEIVED


AUG 03 1987

Department of Natural Resources
 Bureau of Land & Water Resources

DRILLERS REMARKS:

If well telescopes please
sketch and show depths.

GROUND LEVEL

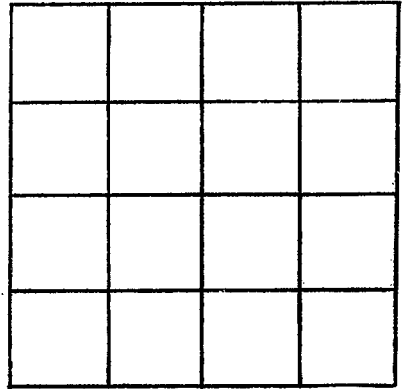

SECTION _____

Please indicate well location X.

ADDITIONAL INFORMATION

If more than one screen,
show locations of each on sketch.