

County: Pontotoc
 Permit #: _____
 Driller: Leeper Drilling
 Date drilling completed: 2-22-13


State Well Report

Part 1

Mississippi Department of Environmental Quality
 Office of Land and Water Resources
 P.O. Box 10631
 Jackson, MS 39289-0631
 (601)961-5210
 (601)354-6938 (fax)

For Office Use Only:
 Aquifer: J15
 Well #: K23
 L. S. Elevation: _____
 E-log #: _____

State Law requires that this report be prepared by the driller in detail and filed with the Department within 30 days of completion of drilling of the well.

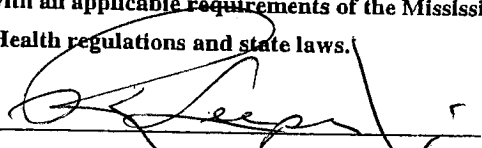Well Owner Information		Well Location	
Owner Name: <u>David Thompson</u>	Latitude: <u>34.08.13708</u>	Longitude: <u>89.07.843</u>	
Mailing Address: <u>4309 Topsy Rd</u>	Method of Lat/Long (circle one): Conventional Survey, _____		
<u>Randolph MS 38864</u>	USGS quad, Hand-held GPS, Survey-grade GPS		
City / State / Zip Code	SW <u>1/4</u> SE <u>1/4</u> Sec. <u>7</u> Twp <u>115</u> Rng <u>2E</u>		
Telephone No. <u>(662) 489-2381</u>	Distance <u>12</u> Miles	Direction <u>SW</u>	Nearest Town <u>Pontotoc</u>
Well Data			
Purpose of Well (circle one) <u>Home</u> Industrial Public Supply Irrigation Fish Culture Other: _____			
Date well drilling started: <u>2-14-13</u>		Date well drilling completed: <u>2-22-13</u>	
If flowing, method of flow regulation: Valve _____ Other (describe) _____			
Static Water Level: <u>120</u> feet above or below (circle one) land surface		Date measured: <u>2-25-13</u>	
Method of Measurement (circle one) <u>steel tape</u> electric tape air line other: _____			
Hole depth: <u>440 ft</u>	Well depth: <u>440 ft</u>	Well grouted to a depth of <u>10</u> feet	
Type of grout (circle one): Cement Bentonite <u>Mix</u>			
Casing length: <u>290</u> feet	Casing diameter: <u>4"</u> inches	Type of casing: <u>PVC</u>	
Screen length: <u>40</u> feet	Screen diameter: <u>2"</u> inches	Type of screen: <u>PVC</u>	
Screen slot size: <u>10/10</u> inches Setting depth: From <u>400</u> feet to <u>440</u> feet			
Type of completion (circle all applicable): Gravel packed Underreamed <u>Telescoped</u> Open hole Natural Development			
Other (describe): _____			
Top of lap pipe or reduction in casing: _____ feet. If telescoped or more than one screen, describe on back of page			
Logs run (circle all applicable): No log run Electric Gamma Ray Density Sonic Neutron Other: _____			
Name of organization running log(s): _____			
I certify that the well was drilled, constructed, and completed in accordance with all applicable requirements of the Mississippi Department of Environmental Quality and/or the Mississippi Department of Health regulations and state laws.			
<u>Leeper Drilling # 0079</u>			
Print Name of Water Well Contractor and License No.		Signature of Water Well Contractor	


RECEIVED

MAR 04 2013

BY: OLWR

If well telescopes please sketch below and show depths.


815 K23

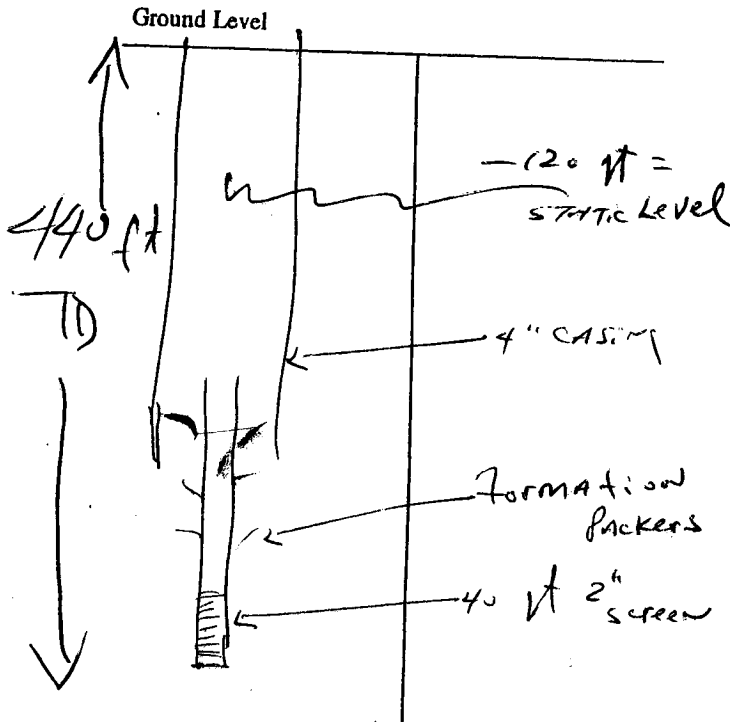

Description of Formations Encountered	From	To
Top Gumbo	0	30
Blue Clay	30	260
CHALK	260	390
SAND	390	440

If more than one screen, show location of each on sketch

Sketch the property layout and include the following: 1) the well location; 2) any permanent structures on the property that may aid in locating the well; 3) any roads, power lines, or other items that may aid in locating the property and the well; 4) indicate direction.

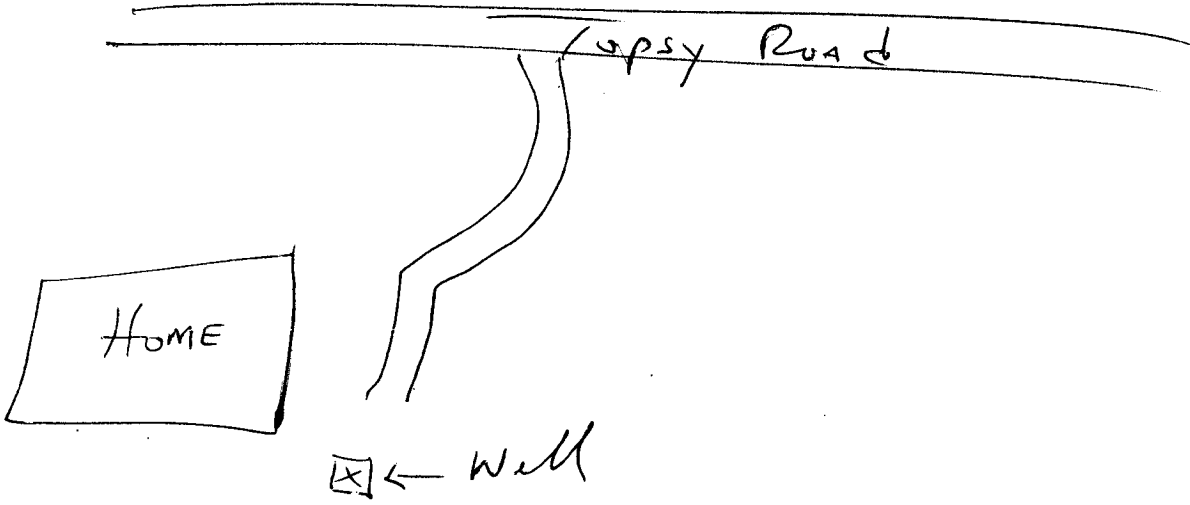

Landowner Name: David Thompson

[Signature]
Signature of Water Well Contractor

RECEIVED
MAR 04 2013
BY: OLWR

STATE WELL REPORT

Part 2

Pump Installer's Completion Report
 Mississippi Department of Environmental Quality
 Office of Land and Water Resources
 P.O. Box 10631
 Jackson, MS 39289-0631
 (601)961-5210
 (601)354-6938 (fax)

315

County: Pontotoc
 Permit #: _____
 Driller: Leeper Drilling
 Date completed: 2-25-13

For Office Use Only:
 Aquifer: _____
 Well #: K23
 Elevation: _____

This report should be prepared by the pump installer in detail and filed with the Department within 30 days of the installation of pump.

Well Owner Information	Well Location
Owner Name: <u>David Thompson</u>	Latitude: <u>34.08.137</u> Longitude: <u>89.07.843</u>
Mailing Address: <u>4309 Topsy Rd</u>	Method of Lat/Long (circle one): <input checked="" type="checkbox"/> Conventional Survey, <input type="checkbox"/> Survey-grade GPS
<u>Randolph MS 38864</u>	USGS quad, <u>Hand-held GPS</u>
City State Zip Code	<u>1/4</u> <u>1/4</u> Sec <u>18</u> Twn <u>11S</u> Rng <u>2E</u>
Telephone No. <u>(601) 489-2381</u>	Distance Direction Nearest Town
	<u>12</u> Miles <u>SW</u> of <u>Pontotoc</u>

Pump Type Circle one	Power Type Circle one
Air Lift <input type="checkbox"/> Jet <input type="checkbox"/> <u>Submersible</u>	Diesel Engine <input type="checkbox"/> Gasoline Engine <input type="checkbox"/> Natural Gas <input type="checkbox"/>
Bucket <input type="checkbox"/> Piston <input type="checkbox"/> Turbine <input type="checkbox"/>	<u>Electric Motor</u> <input checked="" type="checkbox"/> Hand <input type="checkbox"/> Tractor PTO <input type="checkbox"/>
Centrifugal <input type="checkbox"/> Rotary <input type="checkbox"/> Flowing Well <input type="checkbox"/>	Windmill <input type="checkbox"/> Other (specify): _____
Other (specify): _____	Horse Power Rating of Motor: <u>1 HP</u>
Date Pump Installed: <u>2-25-13</u>	Setting Depth: <u>180</u> feet
Rated Pump Capacity: <u>10</u> Gallons Per Minute	Number of Stages: <u>1</u>

Pump Test Data	Method of Measuring Water Level Circle one
Date Well Tested: <u>2-25-13</u>	Air Line <input type="checkbox"/> Electric Measuring Line <input type="checkbox"/> <u>Steel Tape</u>
Static Water Level (A): _____ Feet Below Land Surface	Other (specify): _____
Pumping Water Level (B): <u>120</u> Feet <u>Below</u> Land Surface	For flowing well, measured shut in head: _____ feet
Drawdown [(B) - (A)]: _____ Feet Below Land Surface	Well yielded _____ GPM with a drawdown of _____ feet after _____ hours of pumping
Test Pumping Rate: _____ Gallons Per Minute	
Duration of Pump Test (minimum 4 hours): _____ hours	

I HEREBY CERTIFY that the above statements are true to the best of my knowledge.
Leeper Drilling # 0079
 Print Name of Pump Installer and License No. (if applicable) [Signature]
Signature of Pump Installer

RECEIVED
 MAR 04 2013
 BY: OLWR