

PONTOTOC

K

2000

4-11-78

MISSISSIPPI BOARD OF WATER COMMISSIONERS  
416 North State Street  
Jackson, Mississippi 39201

WATER WELL DRILLERS LOG

4-11

1978

Super

Pontotoc

date well completed

firm name

county well located

LANDOWNER:

Bobby Walker

Rt. 1 Randolph, Mo.  
(mailing address)

description of formations encountered

from

to

Jointed clay	0	20'
Red sand	20	80'
white clay		
Blue clay + Rock	80'	300
Chalk + Rock	300'	416
Sand	410'	510'

WELL LOCATION:

sec. 7 T 11 N R 2 E  
S W  
4 miles E of Randolph  
(distance) (direction) (nearest town)

WELL PURPOSE: Home  
(home, irrigation, municipal, industrial)

WELL COMPLETION DATA:

- (1) diameter (inches) 4
- (2) total depth (feet) 510
- (3) static water level (feet) 96 <sup>below</sup>/<sub>above</sub> top of ground.
- (4) casing steel, 106, (material) (depth)  
(size) if telescope see back.
- (5) screen (length) (depth to top)  
(size) (material)
- (6) pump (HP) (yield gpm)  
Elec. (type power)
- (7) electric log No (yes or no)

(organization running log)

(8) how well bottom plugged open

DRILLERS REMARKS:


RECEIVED

APR 27 1978

MISS. BD. OF WATER COMM

If well telescopes please sketch and show depths.

GROUND LEVEL

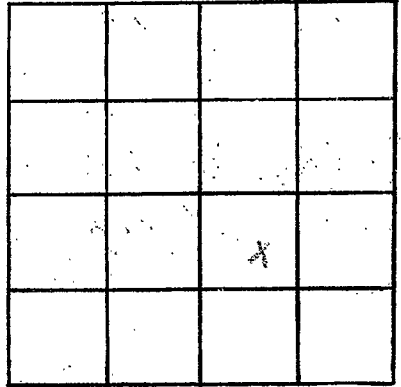

SECTION 7

Please indicate well location X.

ADDITIONAL INFORMATION

If more than one screen, show locations of each on sketch.