

PONTOTOC
 2001 K
 10-14-78-78

MISSISSIPPI
 BOARD OF WATER COMMISSIONERS
 416 North State Street
 Jackson, Mississippi 39201

WATER WELL DRILLERS LOG

10-14-1978 *Leaper* Pontotoc
 date well completed firm name county well located

LANDOWNER *Wm/Ref Patten*
Rt 1

description of formations encountered	from	to
<i>top clay</i>	<i>0</i>	<i>40</i>
<i>blue clay</i>	<i>40</i>	<i>300</i>
<i>Chalk</i>	<i>300</i>	<i>480</i>
<i>sand</i>	<i>480</i>	<i>560</i>

Sarepta, Ms.
 (mailing address)

WELL LOCATION:
 sec. *30* T *11* N R *2* E
20 miles *SW* of *Pontotoc*
 (distance) (direction) (nearest town)

WELL PURPOSE: *Home*
 (home, irrigation, municipal, industrial)

- WELL COMPLETION DATA:
- (1) diameter (inches) *4*
 - (2) total depth (feet) *560'*
 - (3) static water level (feet) *120* below above top of ground.
 - (4) casing *PVC*, *320'*
 (material) (depth)
 - _____ if telescope see back.
 (size)
 - (5) screen _____
 (length) (depth to top)
 - _____ (size) _____ (material)
 - (6) pump *3/4* *10*
 (HP) (yield gpm)
 - Elec*
 (type power)
 - (7) electric log *No*
 (yes or no)
 - _____ (organization running log)
 - (8) how well bottom plugged *open*

DRILLERS REMARKS:


Miss. Board of Water Comm.

FEB 16 1979

RECEIVED

If well telescopes please sketch and show depths.

GROUND LEVEL

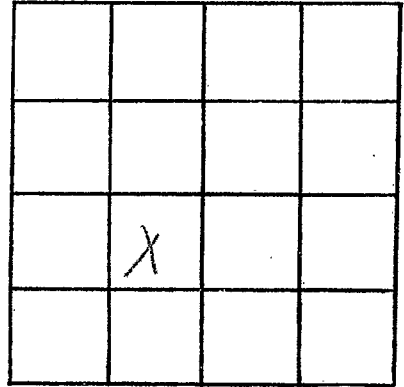

SECTION 30

Please indicate well location X.

ADDITIONAL INFORMATION

If more than one screen,
show locations of each on sketch.