

Pontotoc
K 2003
12/7/89
DEC 7
 date well completed


MISSISSIPPI
 BOARD OF WATER COMMISSIONERS
 416 North State Street
 Jackson, Mississippi 39201

WATER WELL DRILLERS LOG

19 79 LEEPER Drilling Pontotoc
 firm name county well located


| LANDOWNER: | description of formations encountered | from | to |
|---|---------------------------------------|------------|------------|
| <u>Donald Washington</u> <u>Pontotoc MS</u> (mailing address) | | | |
| WELL LOCATION: sec <u>30</u> T <u>11</u> N R <u>2</u> E <u>2</u> miles <u>Miles Buckhorn</u> of (distance) (direction) (nearest town) | <u>Blue clay</u> | <u>20</u> | <u>120</u> |
| WELL PURPOSE: (home, irrigation, municipal, industrial) | <u>Chalk</u> | <u>120</u> | <u>210</u> |
| WELL COMPLETION DATA: | <u>Coarse SAND</u> | <u>210</u> | <u>225</u> |
| (1) diameter (inches) <u>4"</u> | <u>Chalk</u> | <u>225</u> | <u>330</u> |
| (2) total depth (feet) <u>385</u> | <u>SAND</u> | <u>330</u> | <u>385</u> |
| (3) static water level (feet) <u>90</u> below top of ground. | | | |
| (4) casing <u>PVC</u> , <u>142'</u> (material) (depth) | | | |
| (size) if telescope see back. | | | |
| (5) screen <u>None</u> (length) (depth to top) | | | |
| (size) (material) | | | |
| (6) pump <u>1HP</u> <u>100gpm</u> (HP) (yield gpm) | | | |
| <u>elec</u> (type power) | | | |
| (7) electric log <u>NO</u> (yes or no) | | | |
| (organization running log) | | | |
| (8) how well bottom plugged | | | |

DRILLERS REMARKS:

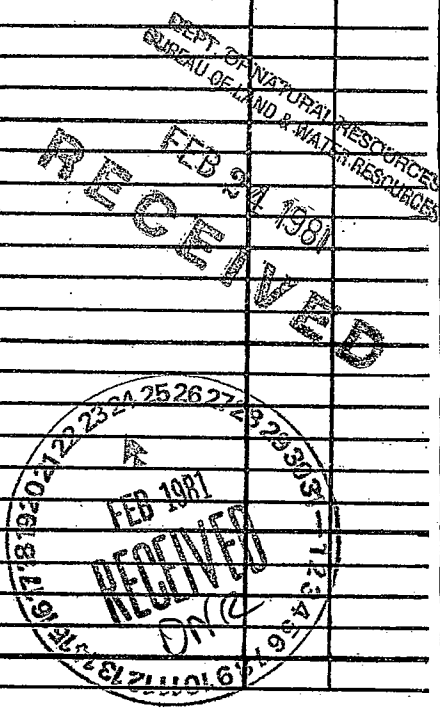

If well telescopes please sketch and show depths.

GROUND LEVEL

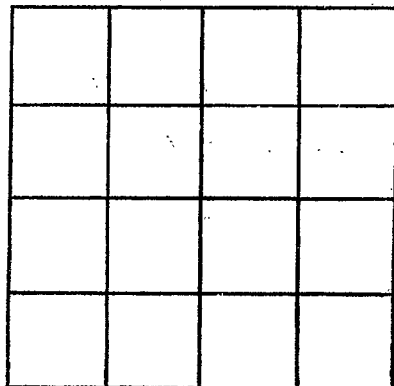

SECTION _____

Please indicate well location X.

ADDITIONAL INFORMATION

If more than one screen, show locations of each on sketch.