

Pontotoc
K 2000
18/80
Aug

MISSISSIPPI
 BOARD OF WATER COMMISSIONERS
 416 North State Street
 Jackson, Mississippi 39201

WATER WELL DRILLERS LOG

date well completed 1980 firm name LEPPER Drilling county well located Pontotoc

LANDOWNER: Ronald Washington
Pontotoc MS
 (mailing address)

description of formations encountered	from	to
<u>TOP CLAY</u>	<u>0</u>	<u>20</u>
<u>BLUE CLAY</u>	<u>20</u>	<u>160</u>
<u>CHALK</u>	<u>160</u>	<u>340</u>
<u>SAND</u>	<u>340</u>	<u>400</u>


WELL LOCATION:
 sec. 30 T 1 N R 2 E
2 miles E of Buckhorn
 (distance) (direction) (nearest town)

WELL PURPOSE: Home
 (home, irrigation, municipal, industrial)

WELL COMPLETION DATA:


- (1) diameter (inches) 4
- (2) total depth (feet) 400
- (3) static water level (feet) 80 below above top of ground
- (4) casing PVC 160
 (material) (depth)
 (size) if telescope see back.
- (5) screen None
 (length) (depth to top)
 (size) (material)
- (6) pump 1HP 10
 (HP) (yield gpm)
 (type power)
- (7) electric log _____
 (yes or no)
 (organization running log)
- (8) how well bottom plugged OPEN

DRILLERS REMARKS:

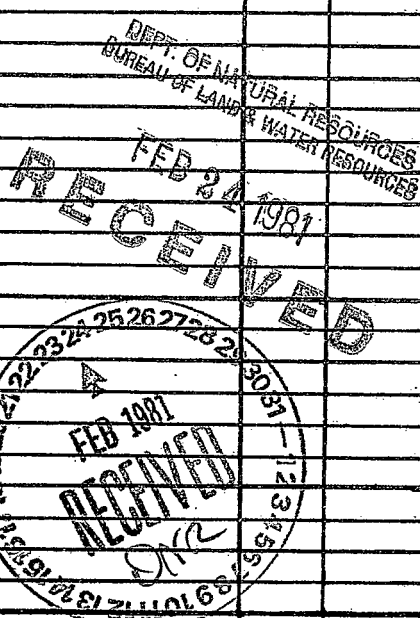

If well telescopes please sketch and show depths.

GROUND LEVEL

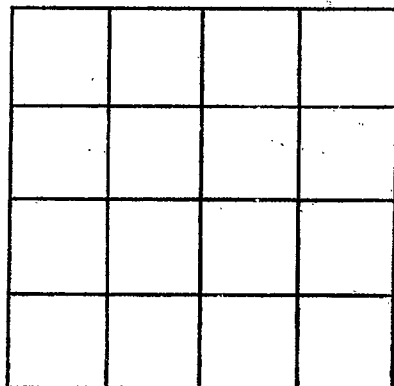

SECTION _____

Please indicate well location X.

ADDITIONAL INFORMATION

If more than one screen,
show locations of each on sketch.