

MISSISSIPPI DEPARTMENT OF NATURAL RESOURCES

Bureau of Land and Water Resources

Southport Mall

P.O. Box 10631

Jackson, Mississippi 39209

WATER WELL DRILLERS LOG

*see*  
*2005*

*4-8-80* date well completed      *SD Leaper Drilling Pontotoc* firm name      *Pontotoc* county well located

LANDOWNER:  
*Conrad Washington*  
*Pontotoc*  
(mailing address)

description of formations encountered	from	to
<i>Top clay</i>	<i>0</i>	<i>20</i>
<i>Blue clay</i>	<i>20</i>	<i>180</i>
<i>Chalk</i>	<i>180</i>	<i>400</i>
<i>Sand</i>	<i>400</i>	<i>450</i>

WELL LOCATION:  
sec *4* T *11* N R *2* E  
*S* *W*  
miles of (distance) (direction) of (nearest town)

WELL PURPOSE: *Home*  
(home, irrigation, municipal, industrial)

- WELL COMPLETION DATA:
- (1) diameter (inches) *4*
  - (2) total depth (feet) *450*
  - (3) static water level (feet) *80* below above top of ground.
  - (4) casing *PVC* *200*  
(material) (depth)  
*4* if telescope see back.  
(size)
  - (5) screen *None*  
(length) (depth to top)  
(size) (material)
  - (6) pump *1* *10*  
(HP) (yield gpm)  
*electric*  
(type power)
  - (7) electric log *NO*  
(yes or no)  
(organization running log)
  - (8) how well bottom plugged *OPEN*

DRILLERS REMARKS:


DEPT. OF NATURAL RESOURCES  
BUREAU OF LAND & WATER RESOURCES

MAY - 3 1982

RECEIVED

If well telescopes please sketch and show depths.

GROUND LEVEL

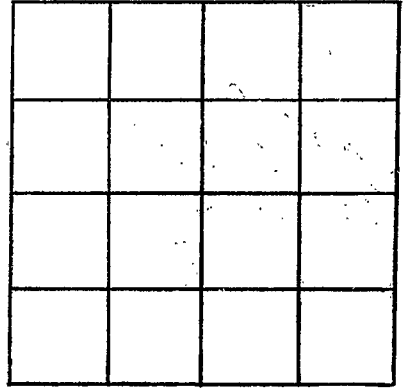

SECTION \_\_\_\_\_

Please indicate well location X.

ADDITIONAL INFORMATION

If more than one screen,  
show locations of each on sketch.