

MISSISSIPPI DEPARTMENT OF NATURAL RESOURCES

Bureau of Land and Water Resources

Southport Mall

P.O. Box 10631

Jackson, Mississippi 39209

WATER WELL DRILLERS LOG

Pontotoc
K
2007

7-24 1981 Leeper Drilling Pontotoc
 date well completed firm name county well located

LANDOWNER: Radi Hefford

description of formations encountered

from

to

Pontotoc, Ms
 (mailing address)

top clay
Blue clay

0 20
20 140

WELL LOCATION:

sec. 19 T. 11 N. R. 2 E
S W

chalk

140 400

_____ miles _____ of _____
 (distance) (direction) (nearest town)

SWD

400 442

WELL PURPOSE: Home
 (home, irrigation, municipal, industrial)

WELL COMPLETION DATA:

- (1) diameter (inches) 4
- (2) total depth (feet) 442
- (3) static water level (feet) 95 below above top of ground
- (4) casing PVC, 412
 (material) (depth)
4" if telescope see back.
 (size)
- (5) screen 30', 412
 (length) (depth to top)
4, PVC
 (size) (material)
- (6) pump 2, 25
 (HP) (yield gpm)
electric
 (type power)
- (7) electric log NO
 (yes or no)

_____ (organization running log)

DEPT. OF NATURAL RESOURCES
 BUREAU OF LAND & WATER RESOURCES

(8) how well bottom plugged: Back Wash Valve


APR 28 1982

DRILLERS REMARKS:

RECEIVED

If well telescopes please sketch and show depths.

GROUND LEVEL

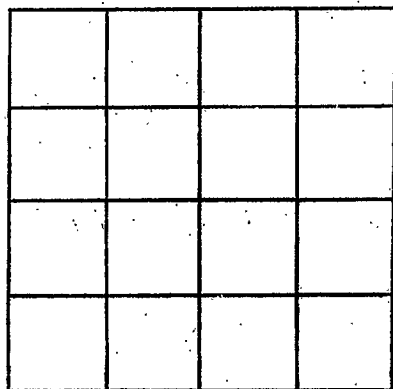

SECTION _____

Please indicate well location X.

ADDITIONAL INFORMATION

If more than one screen,
show locations of each on sketch.