

MISSISSIPPI DEPARTMENT OF NATURAL RESOURCES

Bureau of Land and Water Resources

Southport Mall

P.O. Box 10631

Jackson, Mississippi 39209

WATER WELL DRILLERS LOG

Pontotoc
K 2008

7-20 1981 Keiper Drilling Pontotoc
 date well completed firm name county well located

LANDOWNER: Johnny Logan
Pontotoc, MS

description of formations encountered	from	to
<u>top clay</u>	<u>0</u>	<u>20</u>
<u>Blue clay</u>	<u>20</u>	<u>140</u>
<u>Chalk</u>	<u>140</u>	<u>400</u>
<u>Sand</u>	<u>400</u>	<u>442</u>

(mailing address)

WELL LOCATION:
 sec. 19 T. 11 N. R. 2 E.
 (distance) miles (direction) of (nearest town)

WELL PURPOSE: Home
 (home, irrigation, municipal, industrial)

WELL COMPLETION DATA:

- (1) diameter (inches) 4
- (2) total depth (feet) 442
- (3) static water level (feet) 95 (below/above top of ground)
- (4) casing PVC 4 1/2 (material) (depth)
4 (size) if telescope see back.
- (5) screen 30 4 1/2 (length) (depth to top)
4 (size) PVC (material)
- (6) pump 2 25 (HP) (yield gpm)
electric (type power)
- (7) electric log (yes or no)

(organization running log)

(8) how well bottom plugged: Back-wash valve

DRILLERS REMARKS:


DEPT. OF NATURAL RESOURCES
 BUREAU OF LAND & WATER RESOURCES

APR 28 1982

RECEIVED

If well telescopes please sketch and show depths.

GROUND LEVEL

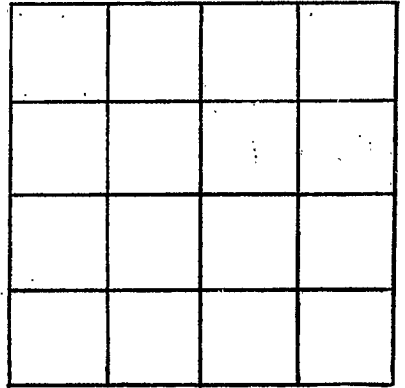

SECTION _____

Please indicate well location X.

ADDITIONAL INFORMATION

If more than one screen, show locations of each on sketch.