

MISSISSIPPI DEPARTMENT OF NATURAL RESOURCES

Bureau of Land and Water Resources

Southport Mall

P.O. Box 10631

Jackson, Mississippi 39209

WATER WELL DRILLERS LOG

Pontotoc
K
2009

10-22 1982 Leeper Drilling Pontotoc
date well completed firm name county well located

LANDOWNER:
Phillip Washington

WELL LOCATION:
sec. 29 T. 11 N. R. 2 E.
15 miles SW of Pontotoc
(distance) (direction) (nearest town)

WELL PURPOSE: Home
(home, irrigation, municipal, industrial)

WELL COMPLETION DATA:

(1) diameter (inches) 4

(2) total depth (feet) 375

(3) static water level (feet) 75 below above
top of ground

(4) casing PC 140
(material) (depth)
4"
(size) If telescope see back.

(5) screen None
(length) (depth to top)
(size) (material)

(6) pump 1 6
(HP) (yield gpm)
electric
(type power)

(7) electric log NO
(yes or no)
(organization running log)

(8) how well bottom plugged OPEN


description of formations encountered	from	to
Top clay	0	20
Blue clay	20	120
Chalk	120	330
SAND	330	375

DEPT. OF NATURAL RESOURCES
BUREAU OF LAND & WATER RESOURCES
DEC-6 1982
RECEIVED

DRILLERS REMARKS:

If well telescopes please sketch and show depths.

GROUND LEVEL

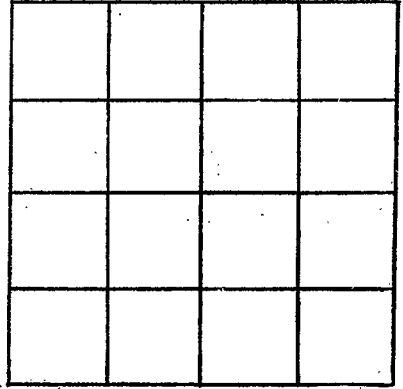

SECTION _____

Please indicate well location X.

ADDITIONAL INFORMATION

If more than one screen,
show locations of each on sketch.