

MISSISSIPPI  
 BOARD OF WATER COMMISSIONERS  
 416 North State Street  
 Jackson, Mississippi 39201

WATER WELL DRILLERS LOG

PONTOTOC  
K 2011  
OCTOBER 1984 date well completed  
Leeper Drilling firm name  
Pontotoc county well located


LANDOWNER:		description of formations encountered	from	to
<u>Stanford Wright</u> <u>Rt 1 Randolph Ms</u> (mailing address)				
WELL LOCATION:		<u>Blue clay</u>	<u>20</u>	<u>180</u>
sec. <u>17</u> T. <u>11</u> N. R. <u>20</u> E. S. <u>5</u> W.	<u>JUDAH COMMUNITY</u> (distance) (direction) (nearest town)	<u>Chalk</u>	<u>180</u>	<u>350</u>
WELL PURPOSE: (home irrigation, municipal, industrial)		<u>SAND</u>	<u>350</u>	<u>400</u>
WELL COMPLETION DATA:				
(1) diameter (inches) <u>4"</u>				
(2) total depth (feet) <u>400</u>				
(3) static water level (feet) <u>85</u> below above top of ground.				
(4) casing <u>Pvc</u> <u>200</u> (material) (depth)				
<u>4"</u> If telescope see back. (size)				
(5) screen <u>None</u> (length) (depth to top)				
(size) (material)				
(6) pump <u>3/4</u> <u>10</u> (HP) (yield gpm)				
<u>Electric</u> (type power)				
(7) electric log <u>NO</u> (yes or no)				
(organization running log)				
(8) how well bottom plugged <u>OPEN</u>				
DRILLERS REMARKS:				

DEPT. OF NATURAL RESOURCES  
 BUREAU OF LAND & WATER RESOURCES

NOV 29 1984  
 RECEIVED

If well telescopes please  
sketch and show depths.

GROUND LEVEL

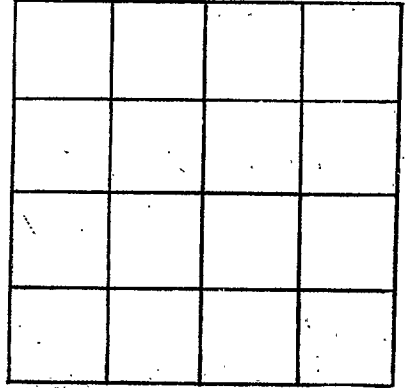

SECTION \_\_\_\_\_

Please indicate well location X.

ADDITIONAL INFORMATION

If more than one screen,  
show locations of each on sketch.