

PONTOTOC
R 2012

MISSISSIPPI
BOARD OF WATER COMMISSIONERS
416 North State Street
Jackson, Mississippi 39201

WATER WELL DRILLERS LOG

10/9 1985 Leeper Drilling Pontotoc
date well completed firm name county well located

LANDOWNER: Ellis Reader
Hiway 9 North
Pontotoc MS.
(mailing address)

WELL LOCATION:
sec. 6 T 11 N R 2 E
4 miles S.W. of ALBAMA
(distance) (direction) (nearest town)

WELL PURPOSE:
(home, irrigation, municipal, industrial)

WELL COMPLETION DATA:

- (1) diameter (inches) 4
- (2) total depth (feet) 240
- (3) static water level (feet) 60 ^{below} _{above} top of ground.
- (4) casing PVC 190
(material) (depth)
4" if telescope see back.
(size)
- (5) screen NONE
(length) (depth to top)
(size) (material)
- (6) pump 3/4 10
(HP) (yield gpm)
Elec
(type power)
- (7) electric log NO
(yes or no)
(organization running log)
- (8) how well bottom plugged OREP

description of formations encountered	from	to
TOP clay	0	20
Blue clay	20	130
Chalk	130	200
SAND	200	240

RECEIVED


NOV 20 1985

DRILLERS REMARKS:

Department of Natural Resources
Bureau of Land & Water Resources

If well telescopes please
sketch and show depths.

GROUND LEVEL

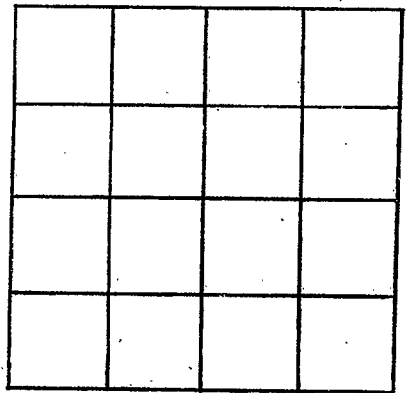

SECTION _____

Please indicate well location X.

ADDITIONAL INFORMATION

If more than one screen,
show locations of each on sketch.