

MISSISSIPPI DEPARTMENT OF NATURAL RESOURCES

Bureau of Land and Water Resources

Southport Mall

P.O. Box 10631

Jackson, Mississippi 39209

WATER WELL DRILLERS LOG

PONTOTOC
K 2015

March 1986
date well completed

LEEPER Drilling
firm name

Pontotoc
county well located

LANDOWNER: Gerald Washington
RT 2 Hazella, Ms.
(mailing address)

description of formations encountered	from	to
<u>Top Gumbo</u>	<u>0</u>	<u>20</u>
<u>Blue clay</u>	<u>20</u>	<u>160</u>
<u>Chalk</u>	<u>160</u>	<u>330</u>
<u>White Sand</u>	<u>330</u>	<u>370</u>

WELL LOCATION:
sec 29 T 11 N R 2 E
18 miles SW of Pontotoc
(distance) (direction) (nearest town)

WELL PURPOSE: Factory
(home, irrigation, municipal, industrial)

WELL COMPLETION DATA:

(1) diameter (inches) 4"

(2) total depth (feet) 370

(3) static water level (feet) 90 below/above top of ground.

(4) casing PVC 340
(material) (depth)
4"
(size) if telescope see back.

(5) screen 30 340
(length) (depth to top)
4" PVC
(size) (material)


(6) pump 3 25
(HP) (yield gpm)
Elec
(type power)

(7) electric log NO
(yes or no)

(organization running log)

(8) how well bottom plugged
Back-wash valve

DRILLERS REMARKS:

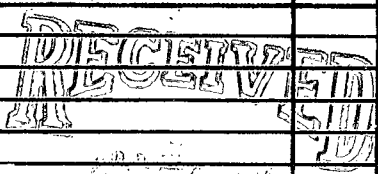

Department of Natural Resources
Bureau of Land & Water Resources

If well telescopes please sketch and show depths.

GROUND LEVEL

SECTION _____

Please indicate well location X.

ADDITIONAL INFORMATION

If more than one screen, show locations of each on sketch.