

PONTOTOC  
K 2016

MISSISSIPPI  
 BOARD OF WATER COMMISSIONERS  
 416 North State Street  
 Jackson, Mississippi 39201

WATER WELL DRILLERS LOG

MAY

date well completed

1986

LEEPER DRILLING

firm name

PONTOTOC

county well located

LANDOWNER: William J. [unclear]

Rt 1 Randolph, Ms.

(mailing address)

WELL LOCATION:

sec. 17 T. 11 N. R. 2 (E)  
(S)  
15 miles SW of PONTOTOC  
 (distance) (direction) (nearest town)

WELL PURPOSE: HOME

(home, irrigation, municipal, industrial)

WELL COMPLETION DATA:


- (1) diameter (inches) 4"
- (2) total depth (feet) 420
- (3) static water level (feet) 90 below above top of ground.
- (4) casing PVC 200  
 (material) (depth)  
4" If telescope see back.  
 (size)
- (5) screen \_\_\_\_\_  
 (length) (depth to top)  
 (size) (material)
- (6) pump 3/4 10  
 (HP) (yield gpm)  
Elec  
 (type power)
- (7) electric log NU  
 (yes or no)  
 (organization running log)
- (8) how well bottom plugged OPEN

description of formations encountered

from

to

<u>Top clay</u>	<u>0</u>	<u>20</u>
<u>Blue clay</u>	<u>20</u>	<u>150</u>
<u>CHALK</u>	<u>150</u>	<u>360</u>
<u>SAND</u>	<u>360</u>	<u>420</u>

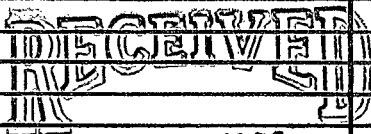

AUG 5 1986

Department of Natural Resources  
 Bureau of Land & Water Management

DRILLERS REMARKS:

scopes please  
show depths.


SECTION \_\_\_\_\_

Please indicate well location X.

ADDITIONAL INFORMATION

If more than one screen,  
show locations of each on sketch.