

PONTOTOC
207

MISSISSIPPI
BOARD OF WATER COMMISSIONERS
416 North State Street
Jackson, Mississippi 39201

WATER WELL DRILLERS LOG


May 19 86 Leeper Drilling Pontotoc
date well completed firm name county well located

LANDOWNER: JAMES L. OWENS
Rt 1 Randolph, MS
(mailing address)
WELL LOCATION:
sec. 17 T. 11 N. R. 2E
15 miles SW of Pontotoc
(distance) (direction) (nearest town)

description of formations encountered	from	to
TOP CLAY	0	20
BLUE CLAY	20	180
CHALK	180	360
SAND	360	410

WELL PURPOSE: Home
(home, irrigation, municipal, industrial)

WELL COMPLETION DATA:
(1) diameter (inches) 4"
(2) total depth (feet) 410
(3) static water level (feet) 90 below above of ground
(4) casing PVC 200 (material) (depth)
4" (size) if telescope see back.
(5) screen (length) (depth to top)
(size) (material)
(6) pump 3/4 10 (HP) (yield gpm)
5 sec (type power)
(7) electric log NU (yes or no)
(organization running log)
(8) how well bottom plugged OPEN

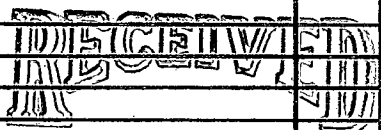


AUG 5 1986

Department of Natural Resources
Bureau of Land & Water Resources

DRILLERS REMARKS:

If well telescopes please
sketch and show depths.

GROUND LEVEL

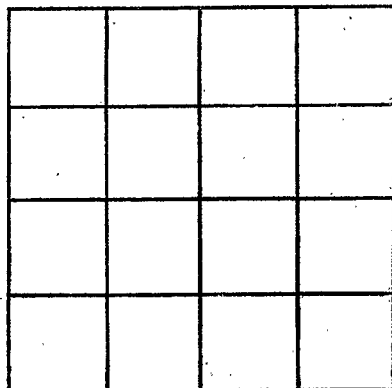

SECTION _____

Please indicate well location X.

ADDITIONAL INFORMATION

If more than one screen,
show locations of each on sketch.