

PONTOTOC  
K  
2024

MISSISSIPPI DEPARTMENT OF NATURAL RESOURCES  
Bureau of Land and Water Resources  
Southport Mall  
P.O. Box 10631  
Jackson, Mississippi 39209  
WATER WELL DRILLERS LOG

MARCH 1986 Leeper Drilling Pontotoc  
date well completed firm name county well located


LANDOWNER: J. A. Dabbs  
Hiway 341 South  
PONTOTOC MS.  
(mailing address)

description of formations encountered	from	to
TOP CLAY	0	20
Blue CLAY	20	160
CHALK	160	300
White Sand	300	345

WELL LOCATION:  
sec. 4 T. 11 N. R. 2 E. S. 3  
12 miles SW of Pontotoc  
(distance) (direction) (nearest town)

WELL PURPOSE: Home  
(home, irrigation, municipal, industrial)

- WELL COMPLETION DATA:
- (1) diameter (inches) 4"
  - (2) total depth (feet) 345
  - (3) static water level (feet) 90 below top of ground.
  - (4) casing PVC, 200' (material), (depth)  
4" (size) if telescope see back.
  - (5) screen NONE (length) (depth to top)
  - (6) pump 1 HP, 10 (HP), (yield gpm)  
Elec (type power)
  - (7) electric log NO (yes or no)
  - (organization running log)
  - (8) how well bottom plugged OPEN

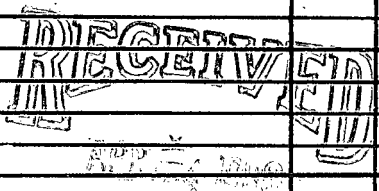


DRILLERS REMARKS:

Department of Natural Resources  
Bureau of Land and Water Resources

If well telescopes please sketch and show depths.

GROUND LEVEL

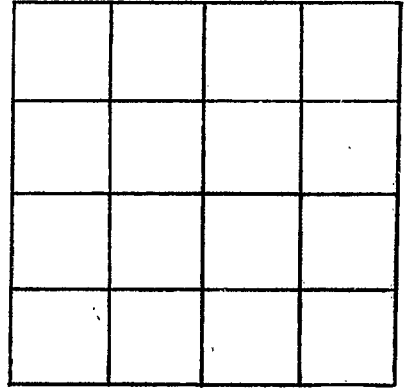

SECTION \_\_\_\_\_

Please indicate well location X.

ADDITIONAL INFORMATION

If more than one screen,  
show locations of each on sketch.