

CODED

Pontotoc
L-28
8-16-68

MISSISSIPPI
BOARD OF WATER COMMISSIONERS
416 North State Street
Jackson, Mississippi 39201

WATER WELL DRILLERS LOG

8-16 1968 Clark Bros. Pontotoc
date well completed firm name county well located

LANDOWNER:

W. D. Walls
Pontotoc Rt. 4
(mailing address)

description of formations encountered

from to

<u>Red clay</u>	<u>0</u>	<u>18</u>
<u>Rock & Sand</u>	<u>18</u>	<u>58</u>
<u>Blue mud</u>	<u>58</u>	<u>150</u>
<u>Rock & Sand</u>	<u>150</u>	<u>200</u>

WELL LOCATION:

sec. 9 T. 11 N. R. 3 E.
7 miles S of Pontotoc
(distance) (direction) (nearest town)


WELL PURPOSE:

Home
(home, irrigation, municipal, industrial)

WELL COMPLETION DATA:

- (1) diameter (inches) 4"
- (2) total depth (feet) 200'
- (3) static water level (feet) 40' below top of ground.
- (4) casing metal, 63' (material) (depth)
4" (size) if telescope see back.
- (5) screen none (length) (depth to top)
(size) (material)
- (6) pump 1 1/2 (HP) 7 (yield gpm)
Electric (type power)
- (7) electric log no (yes or no)
(organization running log)
- (8) how well bottom plugged 700

CODED

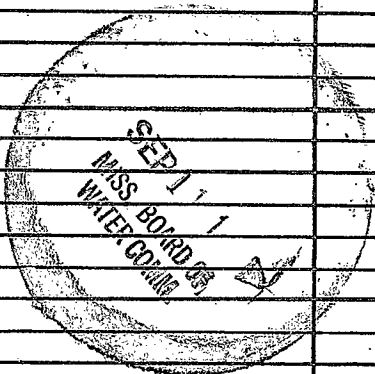

DRILLERS REMARKS:

