

13E

Pontotoc  
L31  
10-26-68

MISSISSIPPI  
BOARD OF WATER COMMISSIONERS  
416 North State Street  
Jackson, Mississippi 39201

CODED

WATER WELL DRILLERS LOG

10-26-68 19 LAMAR WILDER PONTOTOC  
date well completed firm name county well located

LANDOWNER:

GERARD COKE

description of formations encountered

from to

Rt 5 - PONTOTOC

(mailing address)

BACKSHOT  
VOID/CAVITY  
LIMESTONE  
SAND  
BLUE SHALE  
ROCK & SAND

0 18  
18 30  
30 42  
42 60  
60 120  
120 190

WELL LOCATION:


sec 29 T 11 N R 3 E  
S W  
12 miles S of Pontotoc  
(distance) (direction) (nearest town)

WELL PURPOSE: HOME  
(home, irrigation, municipal, industrial)

WELL COMPLETION DATA:

- (1) diameter (inches) 4
- (2) total depth (feet) 192
- (3) static water level (feet) 60 below above top of ground.
- (4) casing STEEL, 99, (material) (depth)  
4" (size) if telescope see back.
- (5) screen (length) (depth to top)  
(size) (material)
- (6) pump 1 (HP) 7 (yield gpm)  
ELECTRIC (type power)
- (7) electric log NO (yes or no)  
(organization running log)
- (8) how well bottom plugged


CODED

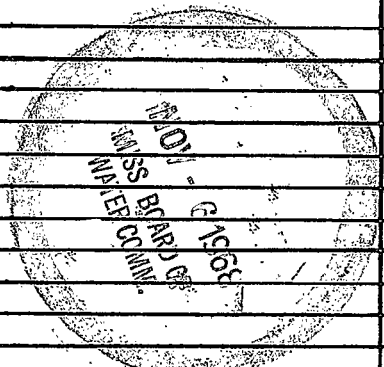

DRILLERS REMARKS:

If well telescopes please sketch and show depths.

GROUND LEVEL

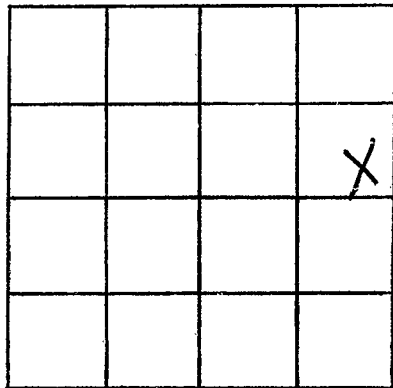

SECTION 29

Please indicate well location X.

ADDITIONAL INFORMATION

If more than one screen, show locations of each on sketch.